


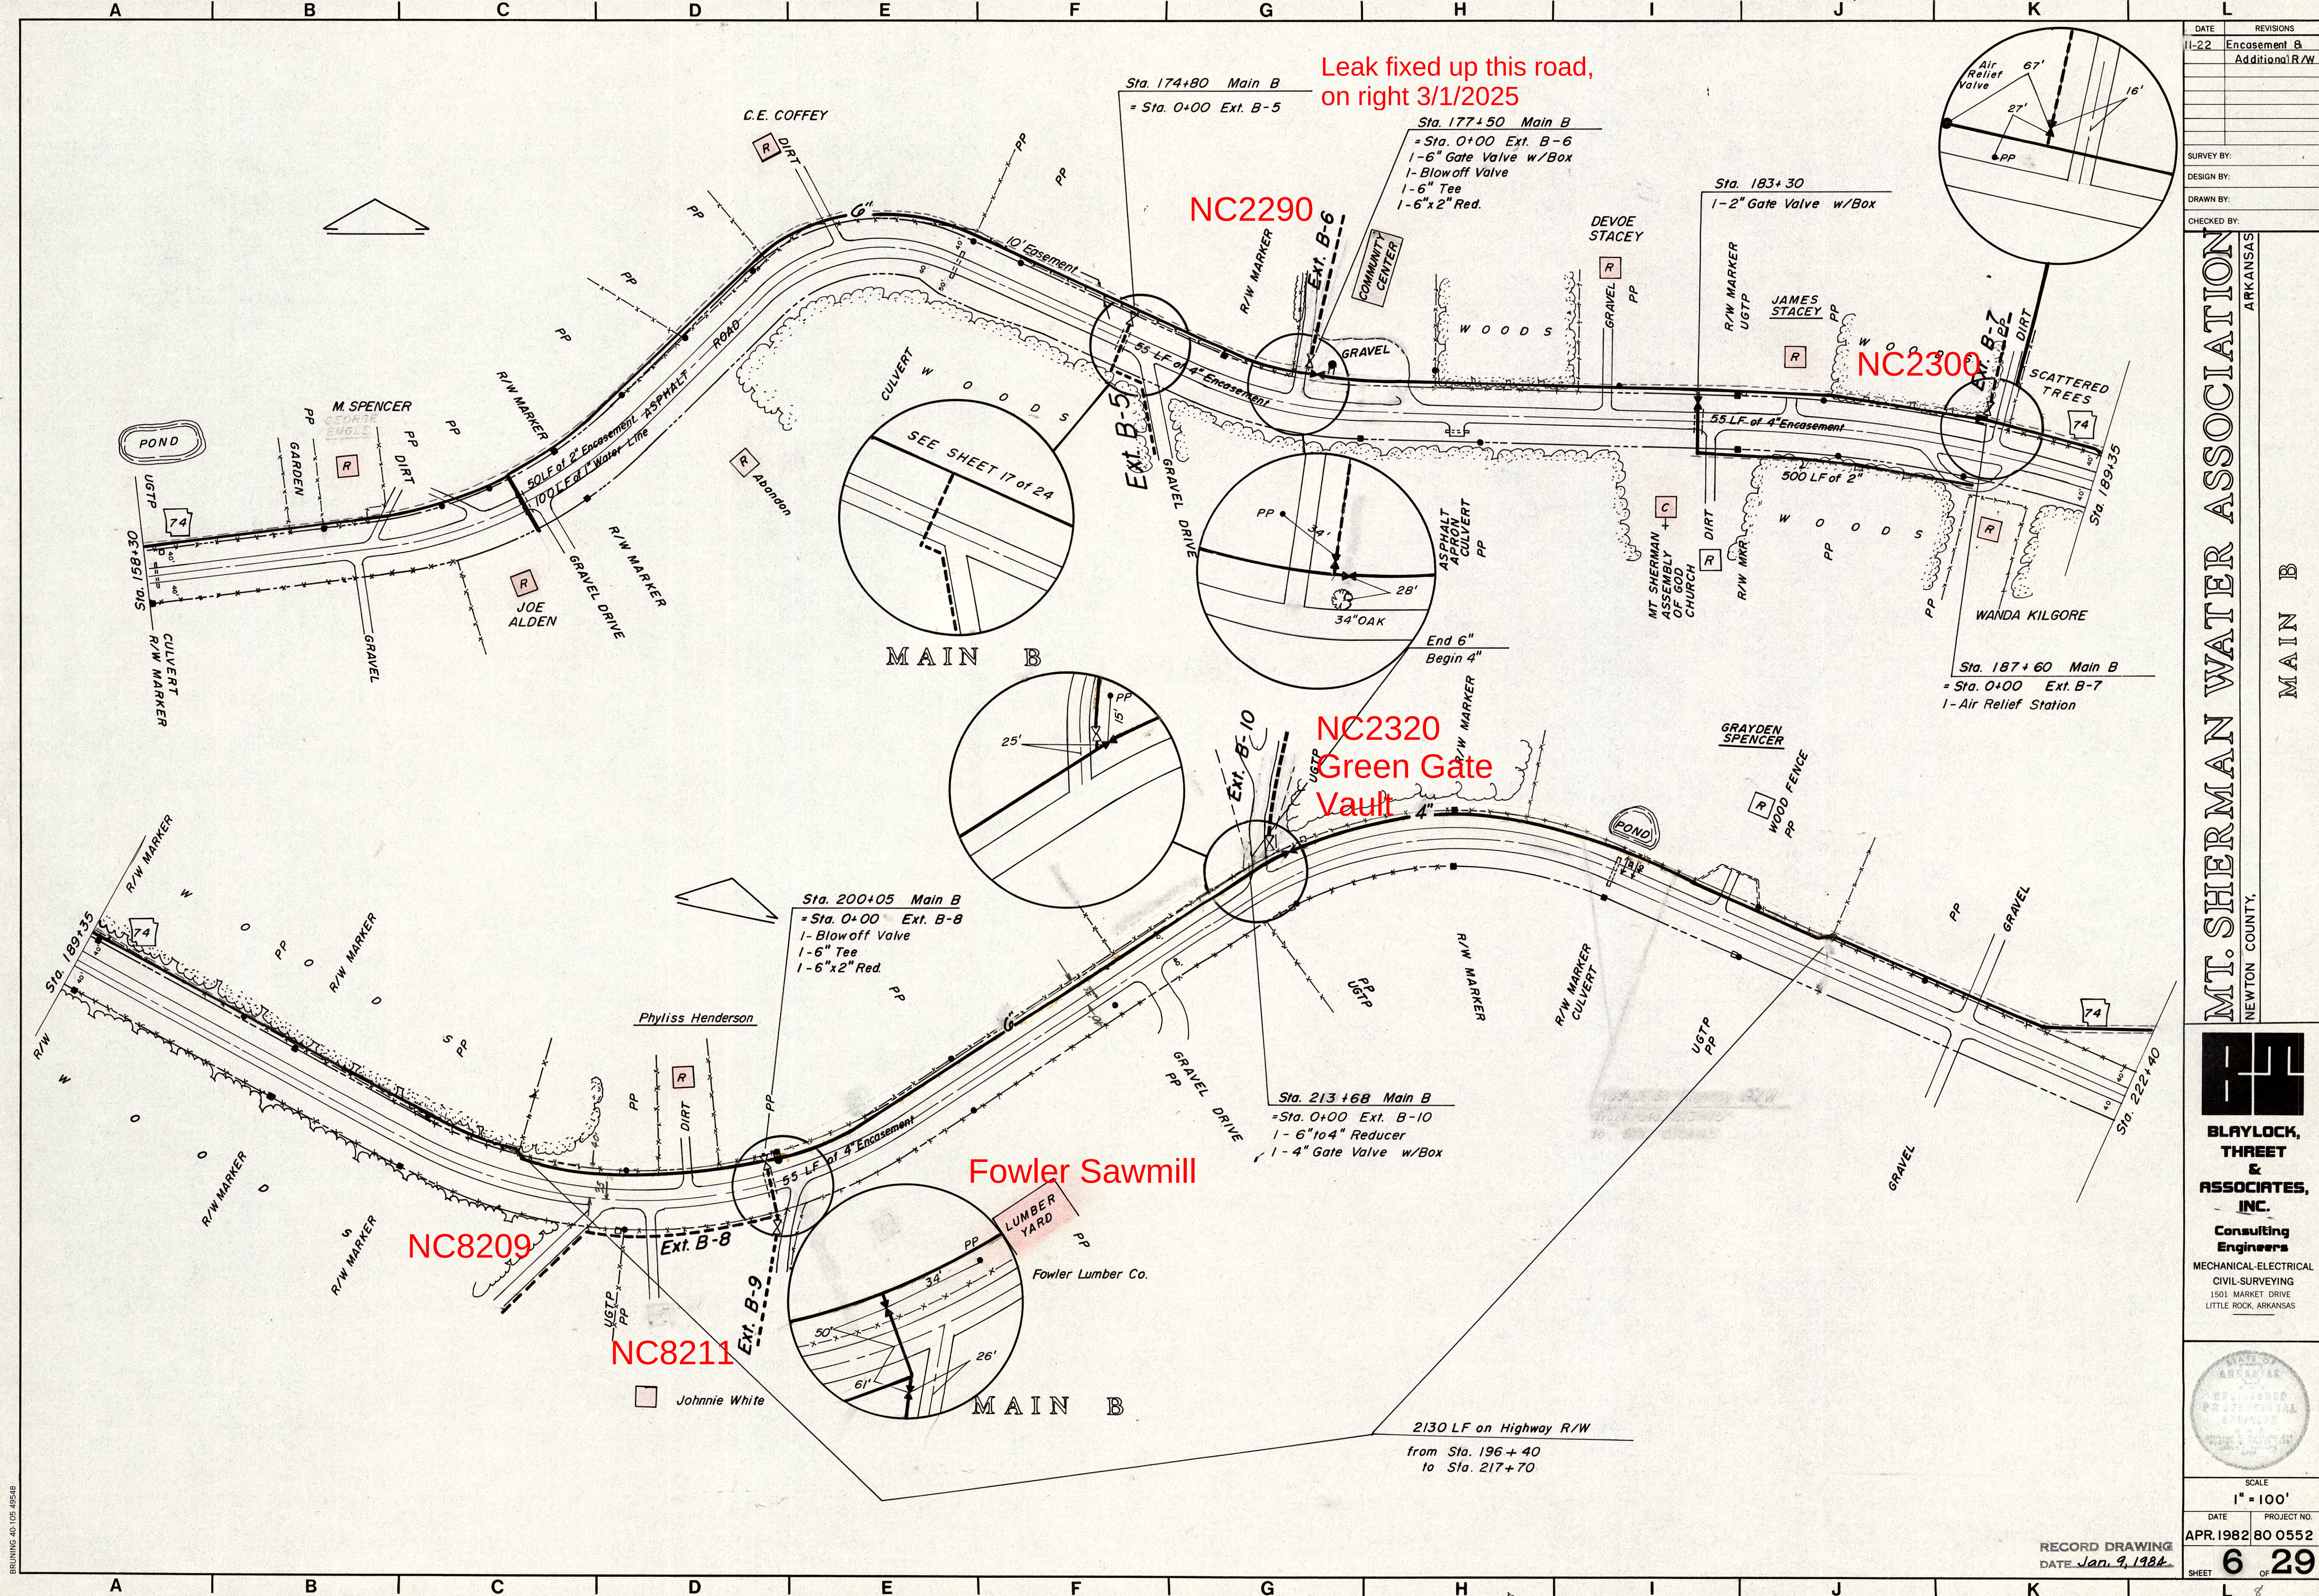

DATE	REVISIONS
11-22	Encasement & Additional R/W

SURVEY BY: _____
 DESIGN BY: _____
 DRAWN BY: _____
 CHECKED BY: _____

MT. SHERMAN WATER ASSOCIATION
 NEWTON COUNTY, ARKANSAS

MAIN B

BLAYLOCK, THREET & ASSOCIATES, INC.
 Consulting Engineers
 MECHANICAL-ELECTRICAL
 CIVIL-SURVEYING
 1501 MARKET DRIVE
 LITTLE ROCK, ARKANSAS

SCALE: 1" = 100'

DATE: APR. 1982
 PROJECT NO.: 80 0552
 SHEET: 6 OF 29

RECORD DRAWING
 DATE: Jan. 9, 1984

BRUNING 40-105 49548