


BRUNING 40-105 49545

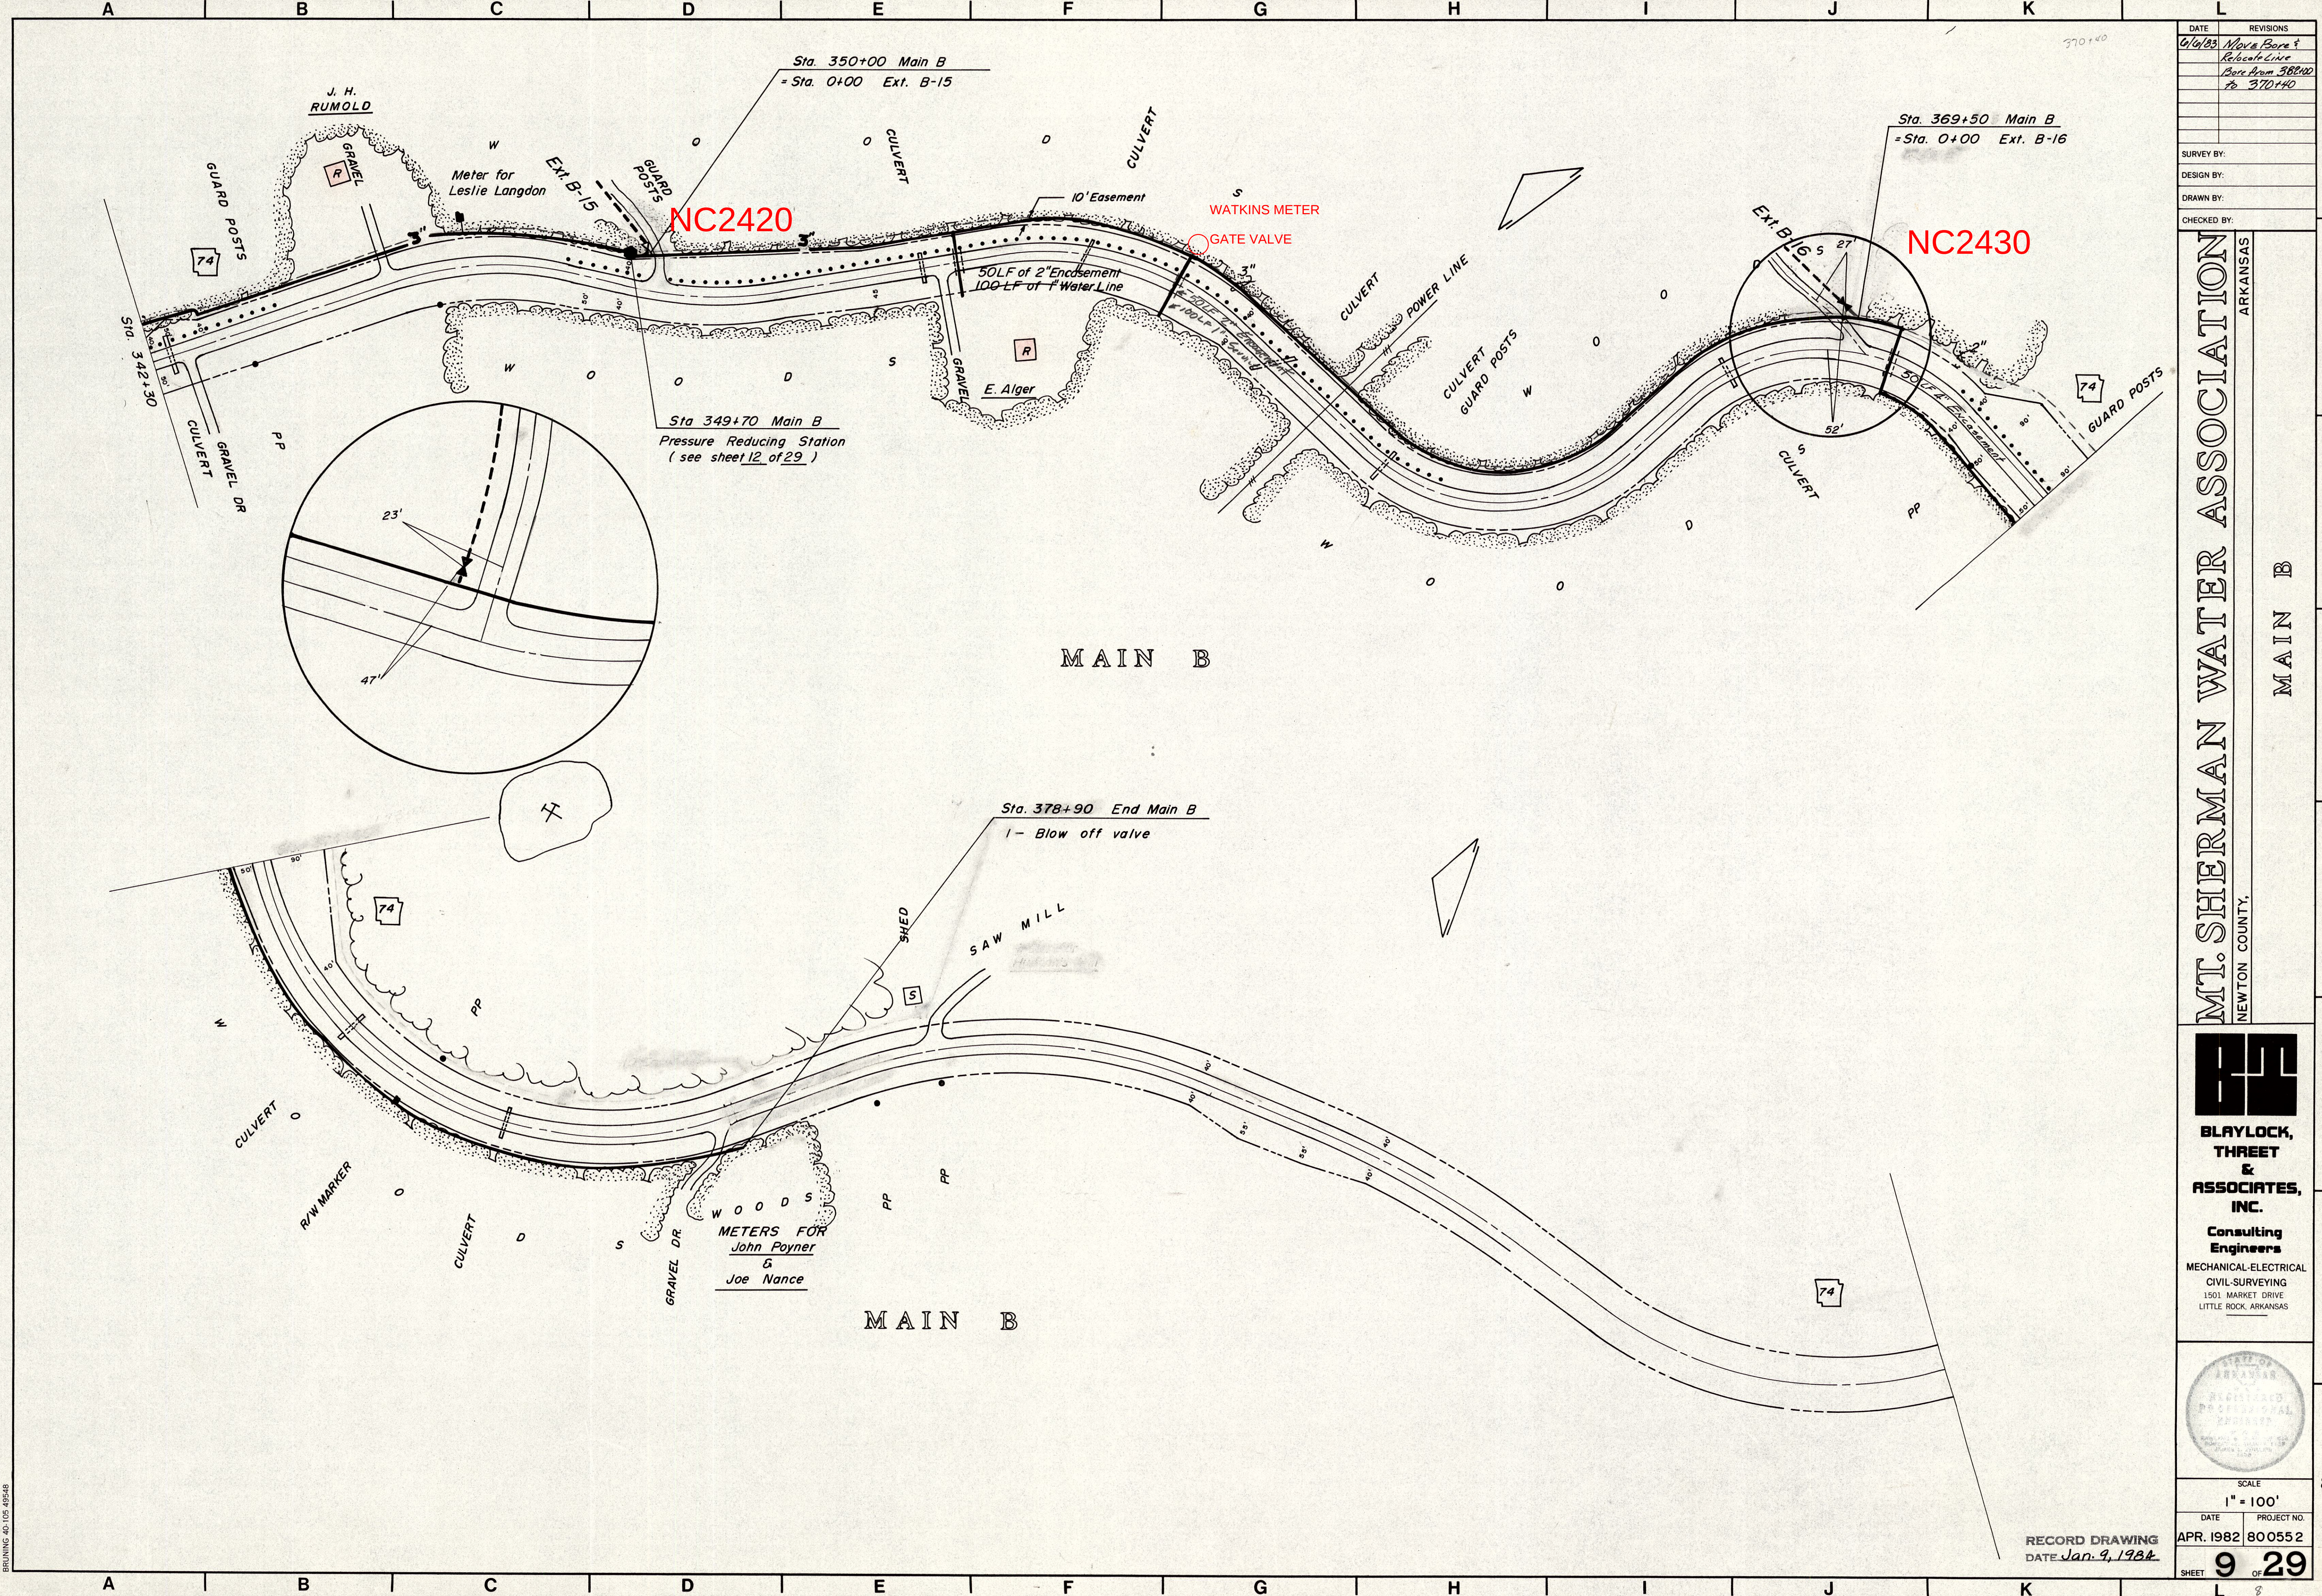

DATE		REVISIONS	
04/93	1	Move Base	
		Relocate Line	
		Base from 388400	
		to 370140	

SURVEY BY:	
DESIGN BY:	
DRAWN BY:	
CHECKED BY:	

MT. SHERMAN WATER ASSOCIATION

NEWTON COUNTY, ARKANSAS

BLAYLOCK, THREET & ASSOCIATES, INC.

Consulting Engineers

MECHANICAL-ELECTRICAL
CIVIL-SURVEYING
1501 MARKET DRIVE
LITTLE ROCK, ARKANSAS

STATE OF ARKANSAS
REGISTERED PROFESSIONAL ENGINEER
No. 12345
Exp. 12/31/95

SCALE
1" = 100'

DATE
APR. 1982

PROJECT NO.
800552

SHEET
9 OF 29

RECORD DRAWING
DATE Jan. 9, 1984