



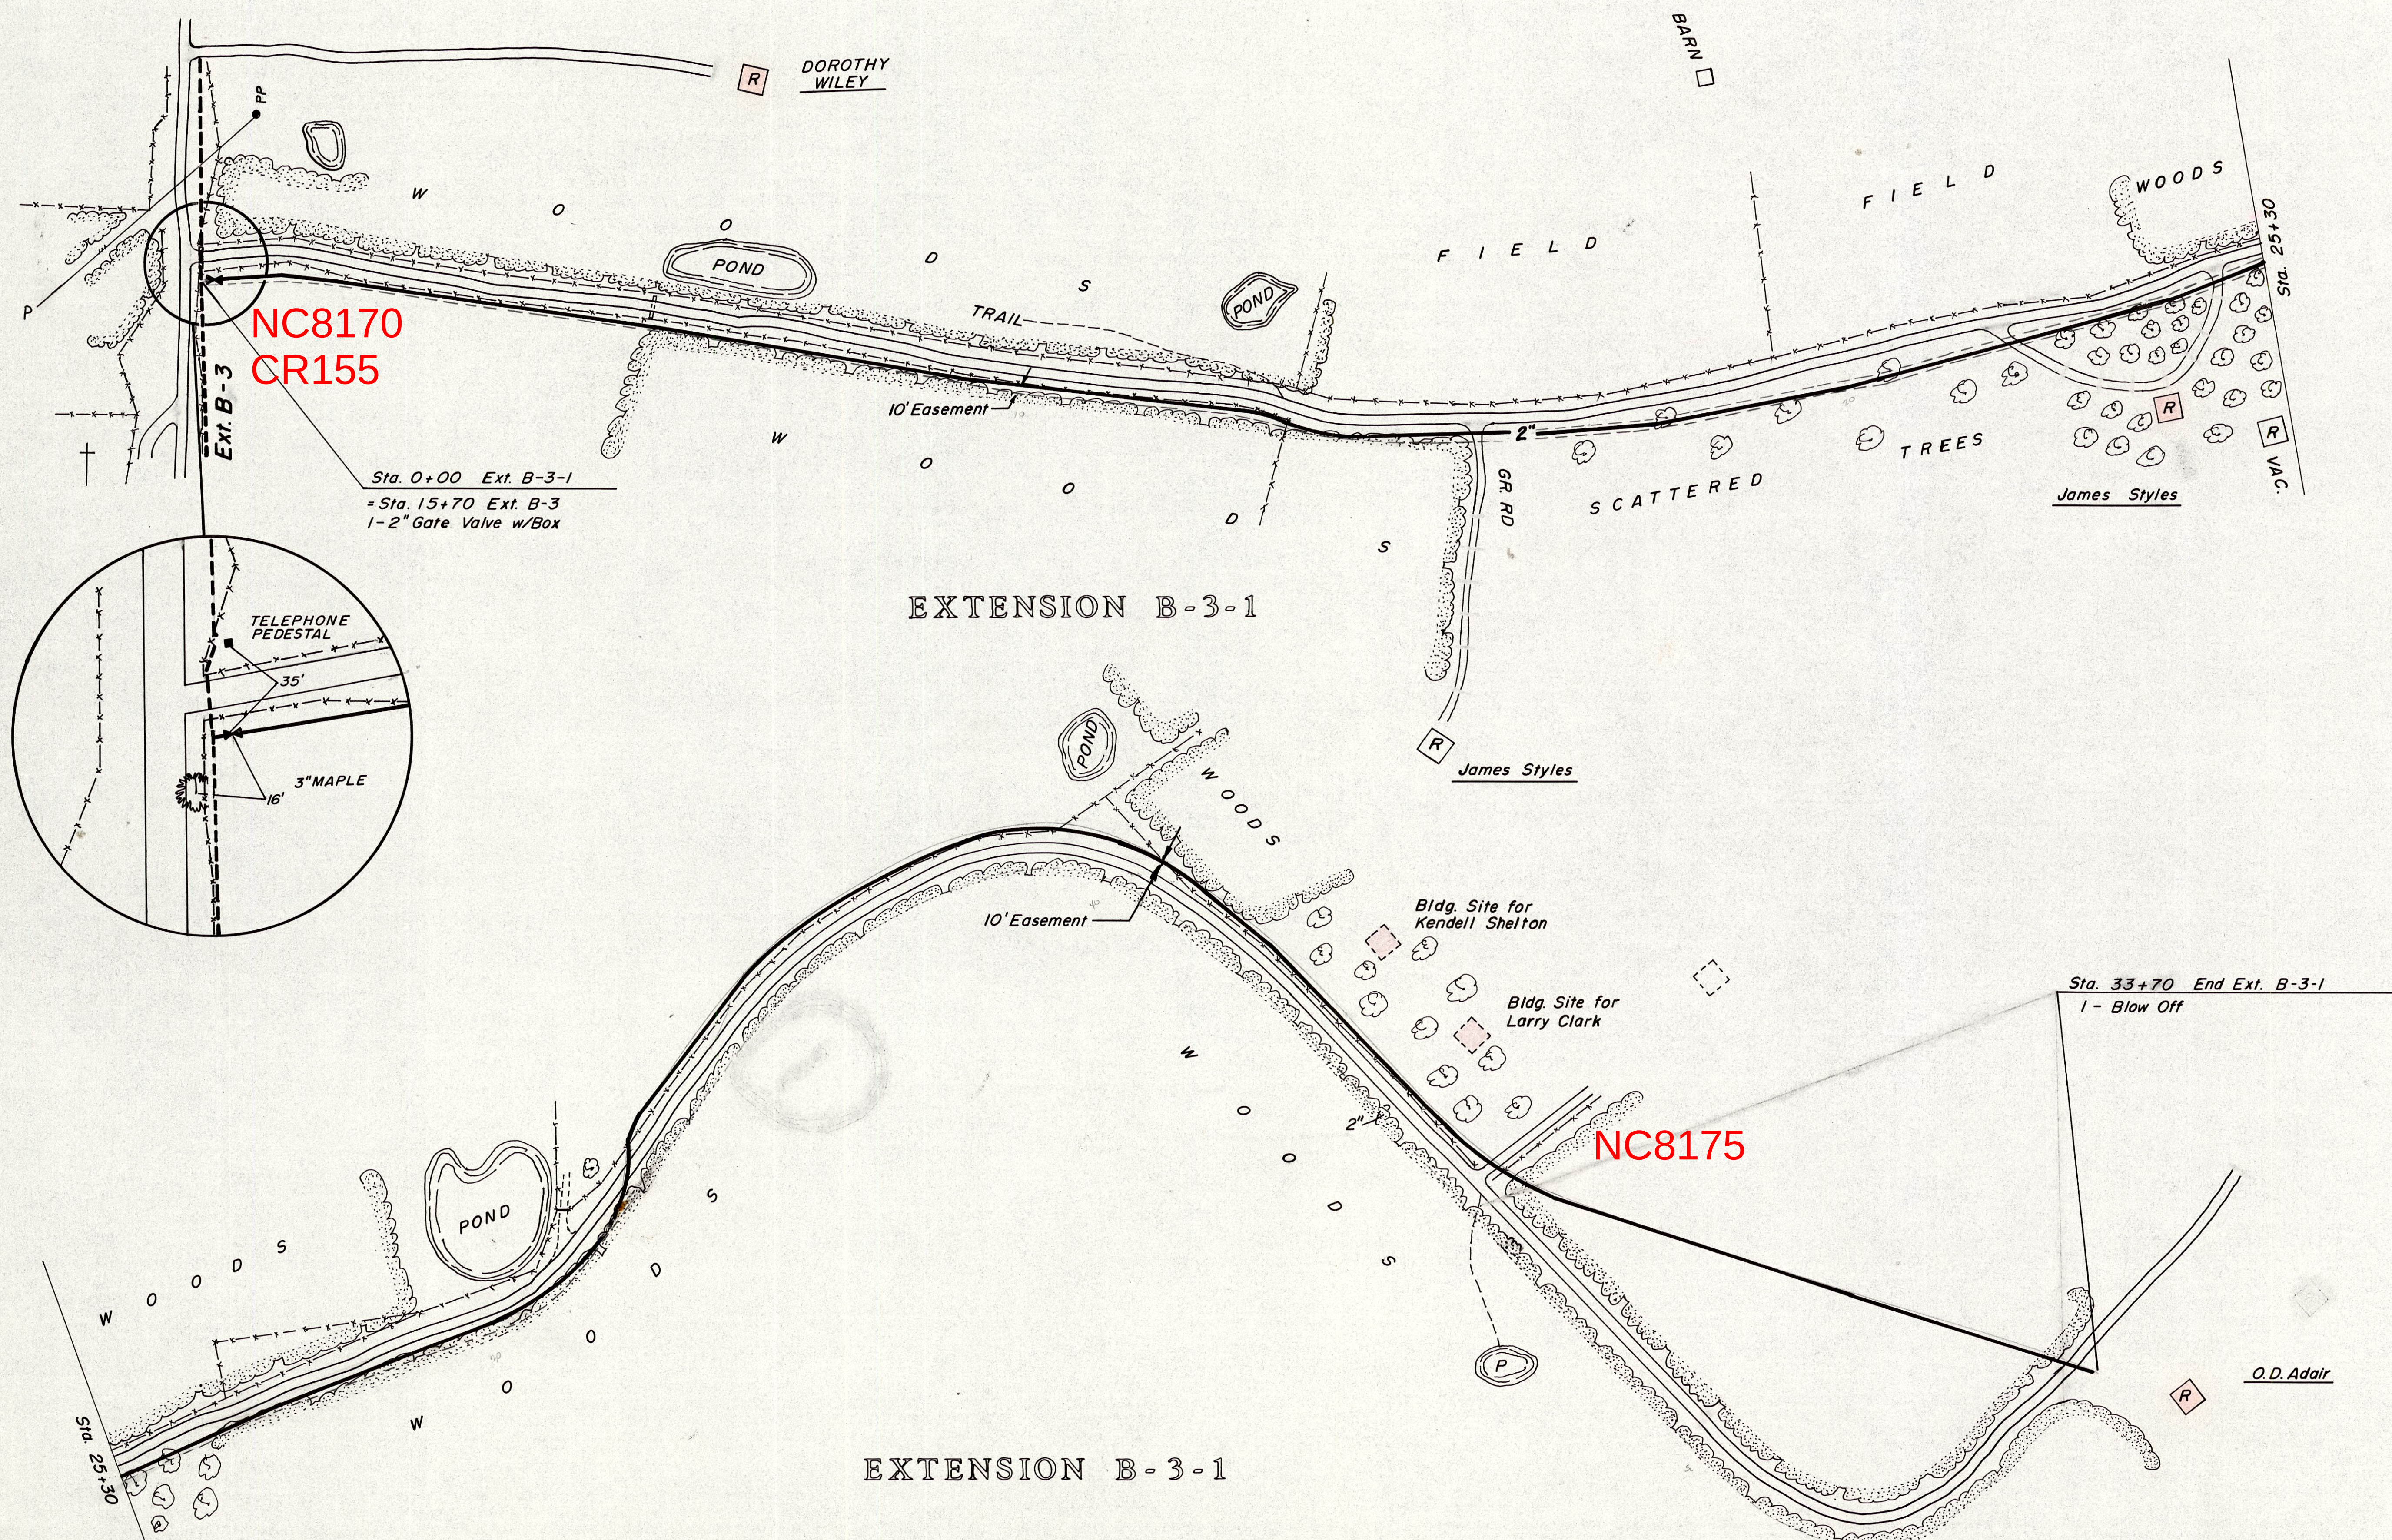

	DATE	REVISIONS
SURVEY BY:		
DESIGN BY:		
DRAWN BY:		
CHECKED BY:		

MT. SHERMAN WATER ASSOCIATION
ADVANCING

EXTENSION B - 3 - 1

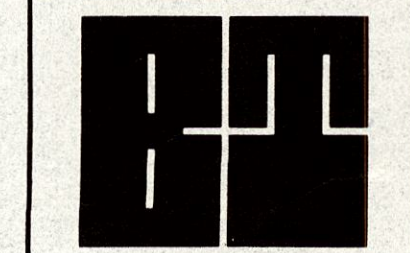

**BLAYLOCK,
THREET
&
ASSOCIATES,
INC.**

**Consulting
Engineers**

**MECHANICAL-ELECTRICAL
CIVIL-SURVEYING**

1501 MARKET DRIVE
LITTLE ROCK, ARKANSAS



SCALE 1" = 100'	
DATE APR. 1982	PROJECT NO. 80 055 2
SHEET 15 OF 29	

RECORD DRAWING
DATE Jan 9, 1984