


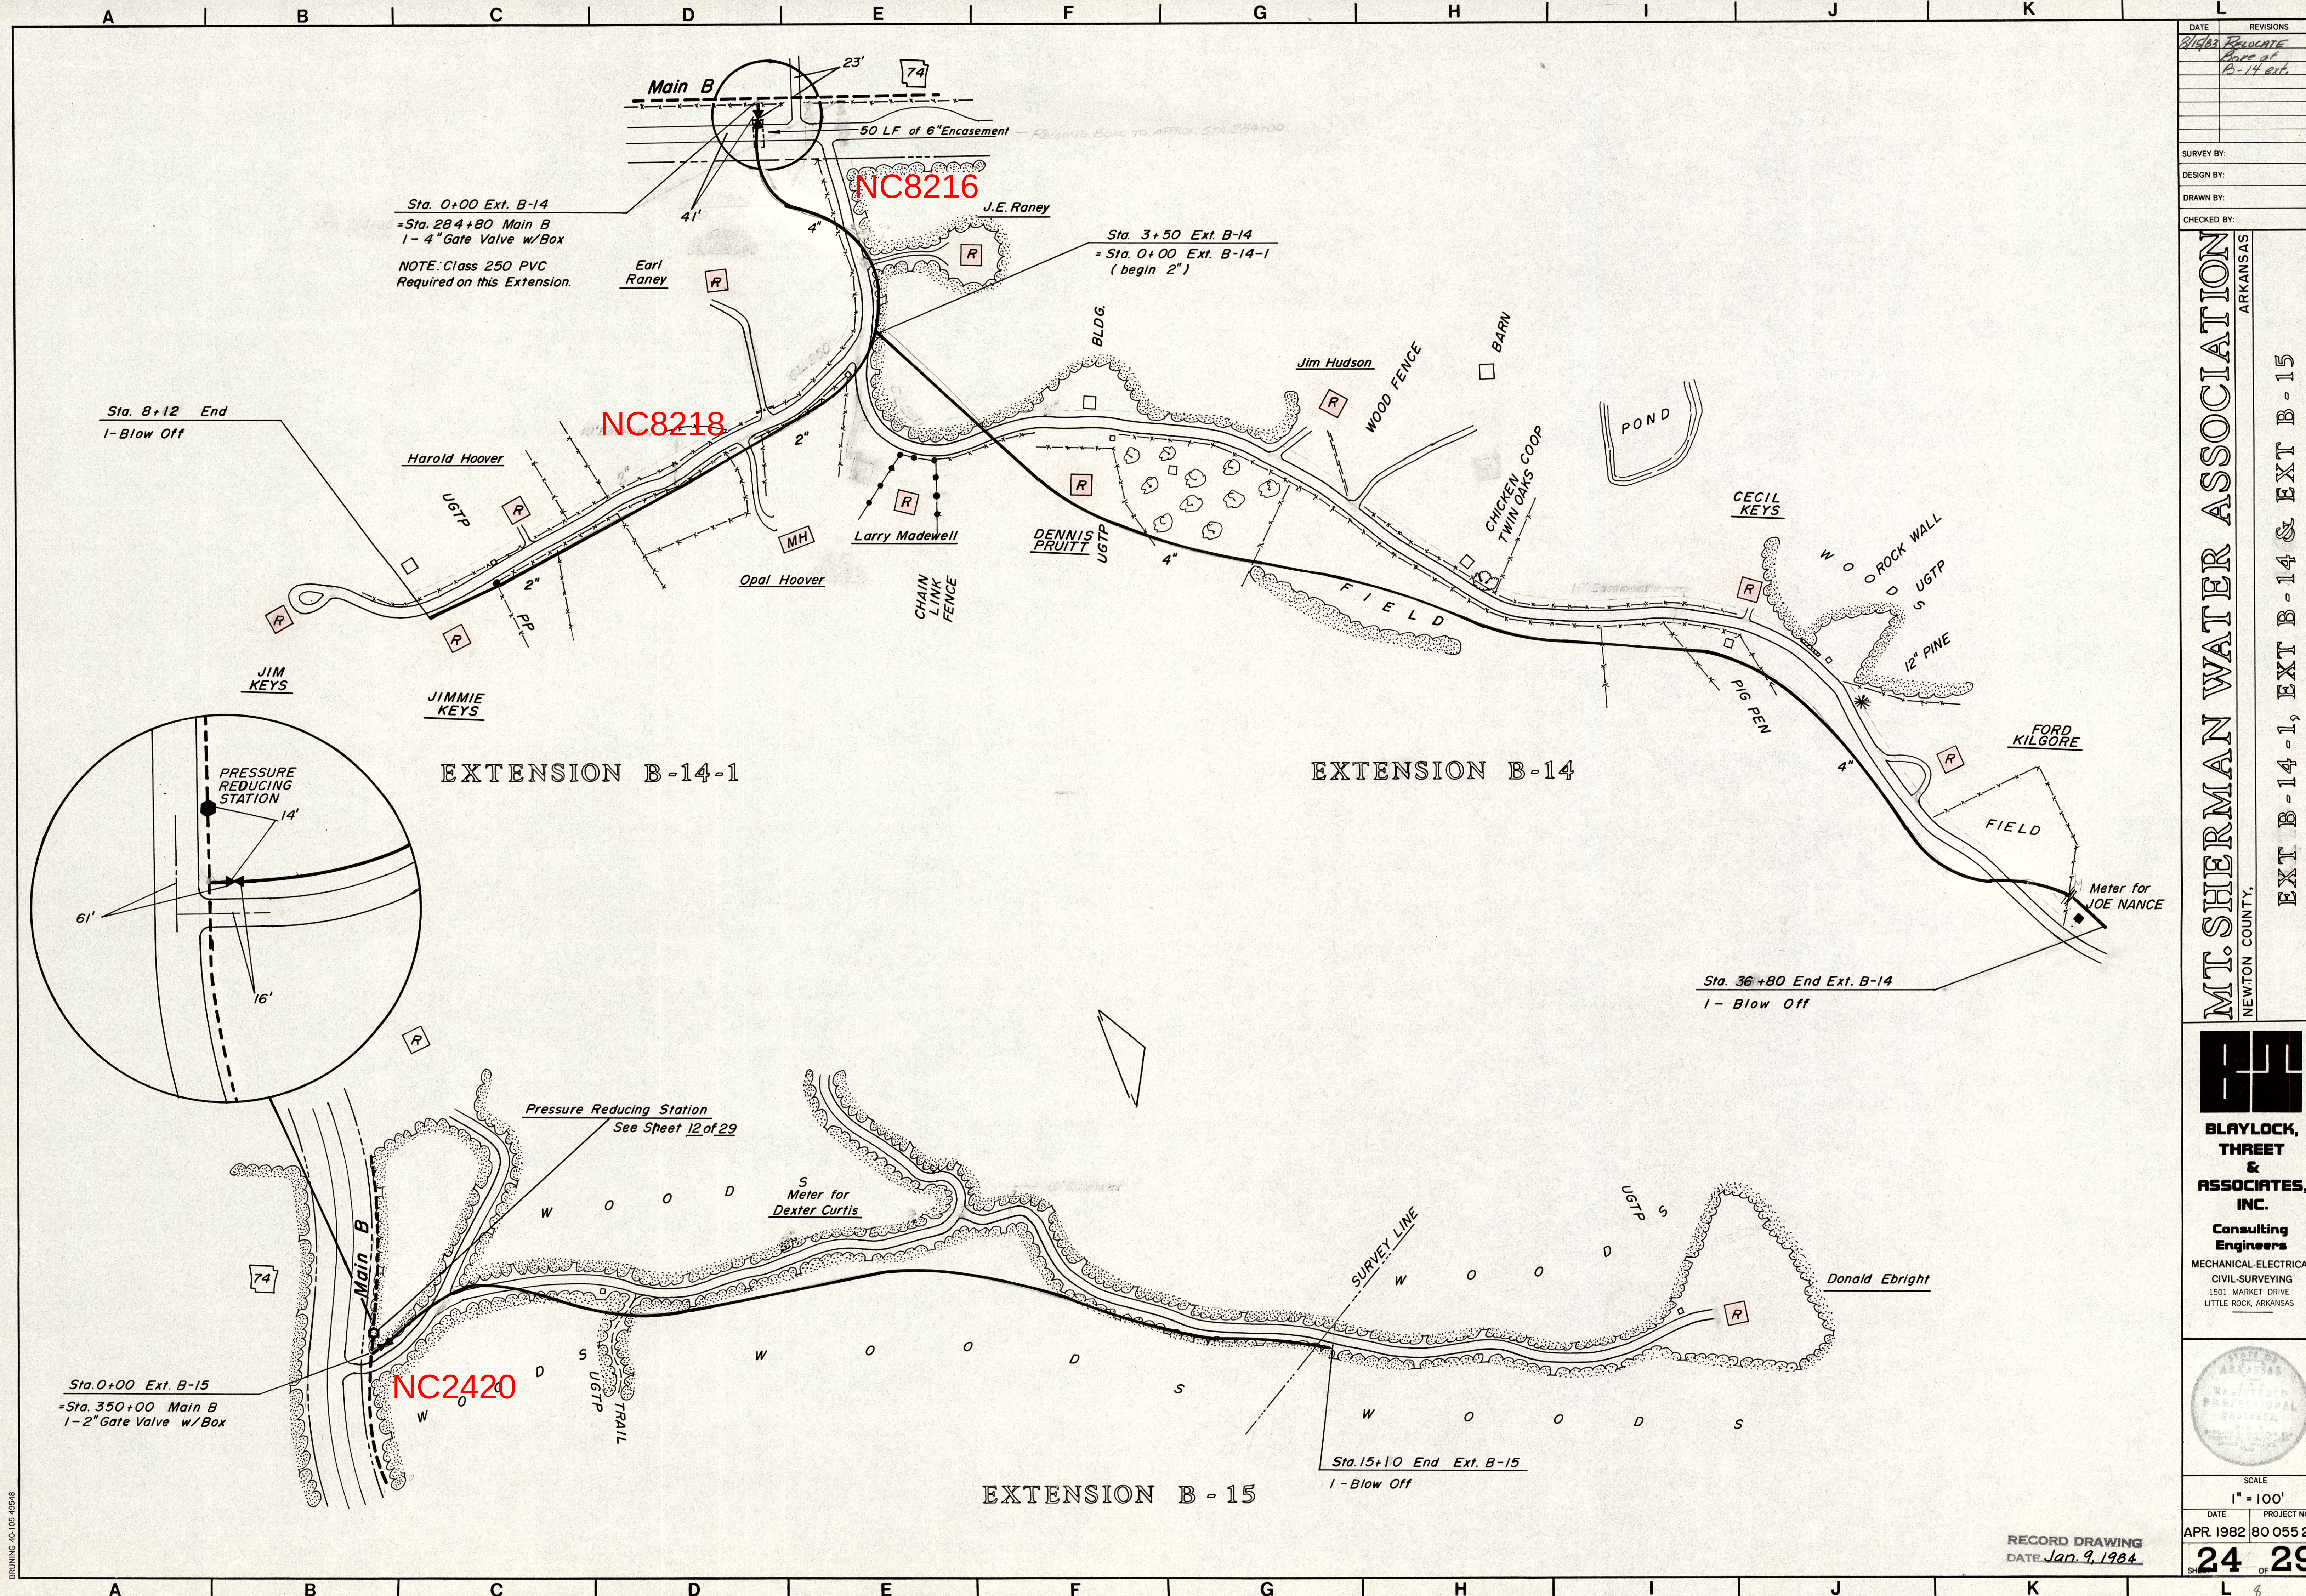

REVISIONS	
DATE	REVISIONS
8/14/83	RELOCATE
	Done at
	B-14 ext.

SURVEY BY:	
DESIGN BY:	
DRAWN BY:	
CHECKED BY:	

MT. SHERMAN WATER ASSOCIATION

NEWTON COUNTY, ARKANSAS

EXT B-14-1, EXT B-14 & EXT B-15

BLAYLOCK, THREET & ASSOCIATES, INC.

Consulting Engineers

MECHANICAL-ELECTRICAL
CIVIL-SURVEYING
1501 MARKET DRIVE
LITTLE ROCK, ARKANSAS

SCALE
1" = 100'

DATE: APR 1982 PROJECT NO.: 80 055 2

24 OF 29

RECORD DRAWING
DATE Jan. 9, 1984

BRUNING 40-105 49548