


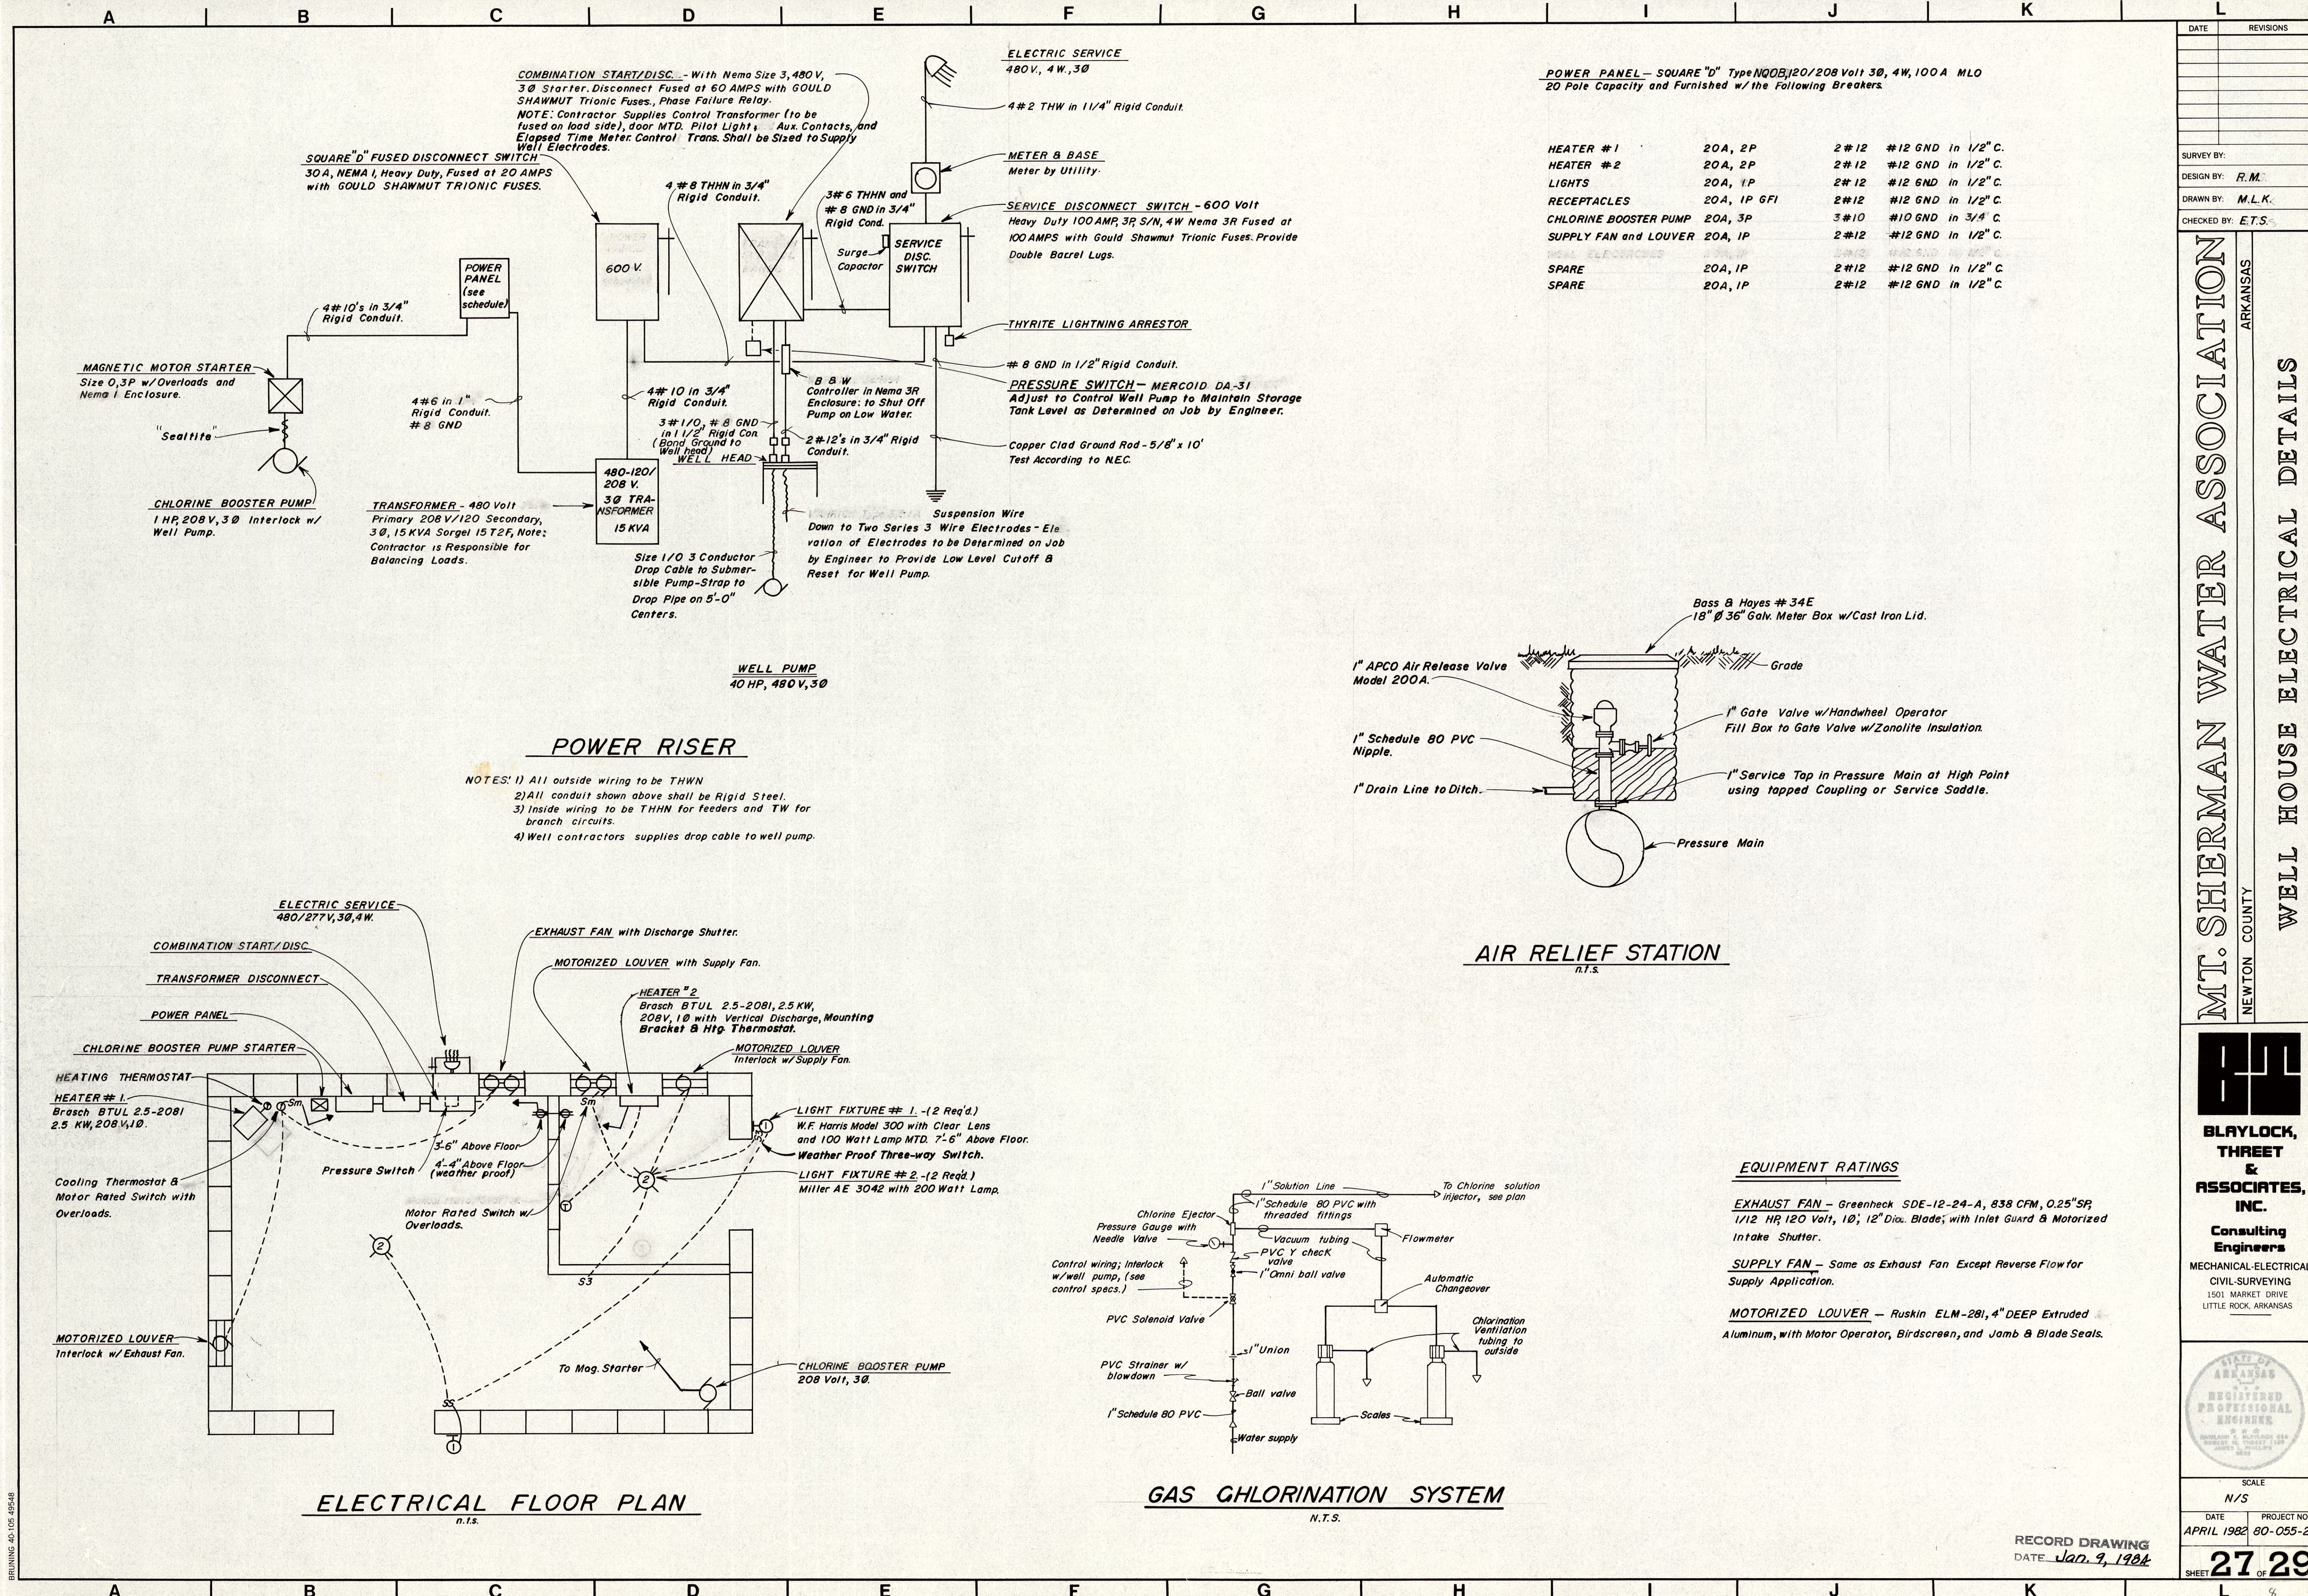

MT. SHERMAN WATER ASSOCIATION
NEWTON COUNTY
WELL HOUSE ELECTRICAL DETAILS

BLAYLOCK, THREET & ASSOCIATES, INC.
Consulting Engineers
MECHANICAL-ELECTRICAL
CIVIL-SURVEYING
1501 MARKET DRIVE
LITTLE ROCK, ARKANSAS

STATE OF ARKANSAS
REGISTERED PROFESSIONAL ENGINEER
ROBERT L. BLAYLOCK, No. 144
JOHN L. THREET, No. 145
JAMES H. BLAYLOCK, No. 146

SCALE
N/S

DATE
APRIL 1982

PROJECT NO.
80-055-2

RECORD DRAWING
DATE Jan. 9, 1984

SHEET 27 OF 29