




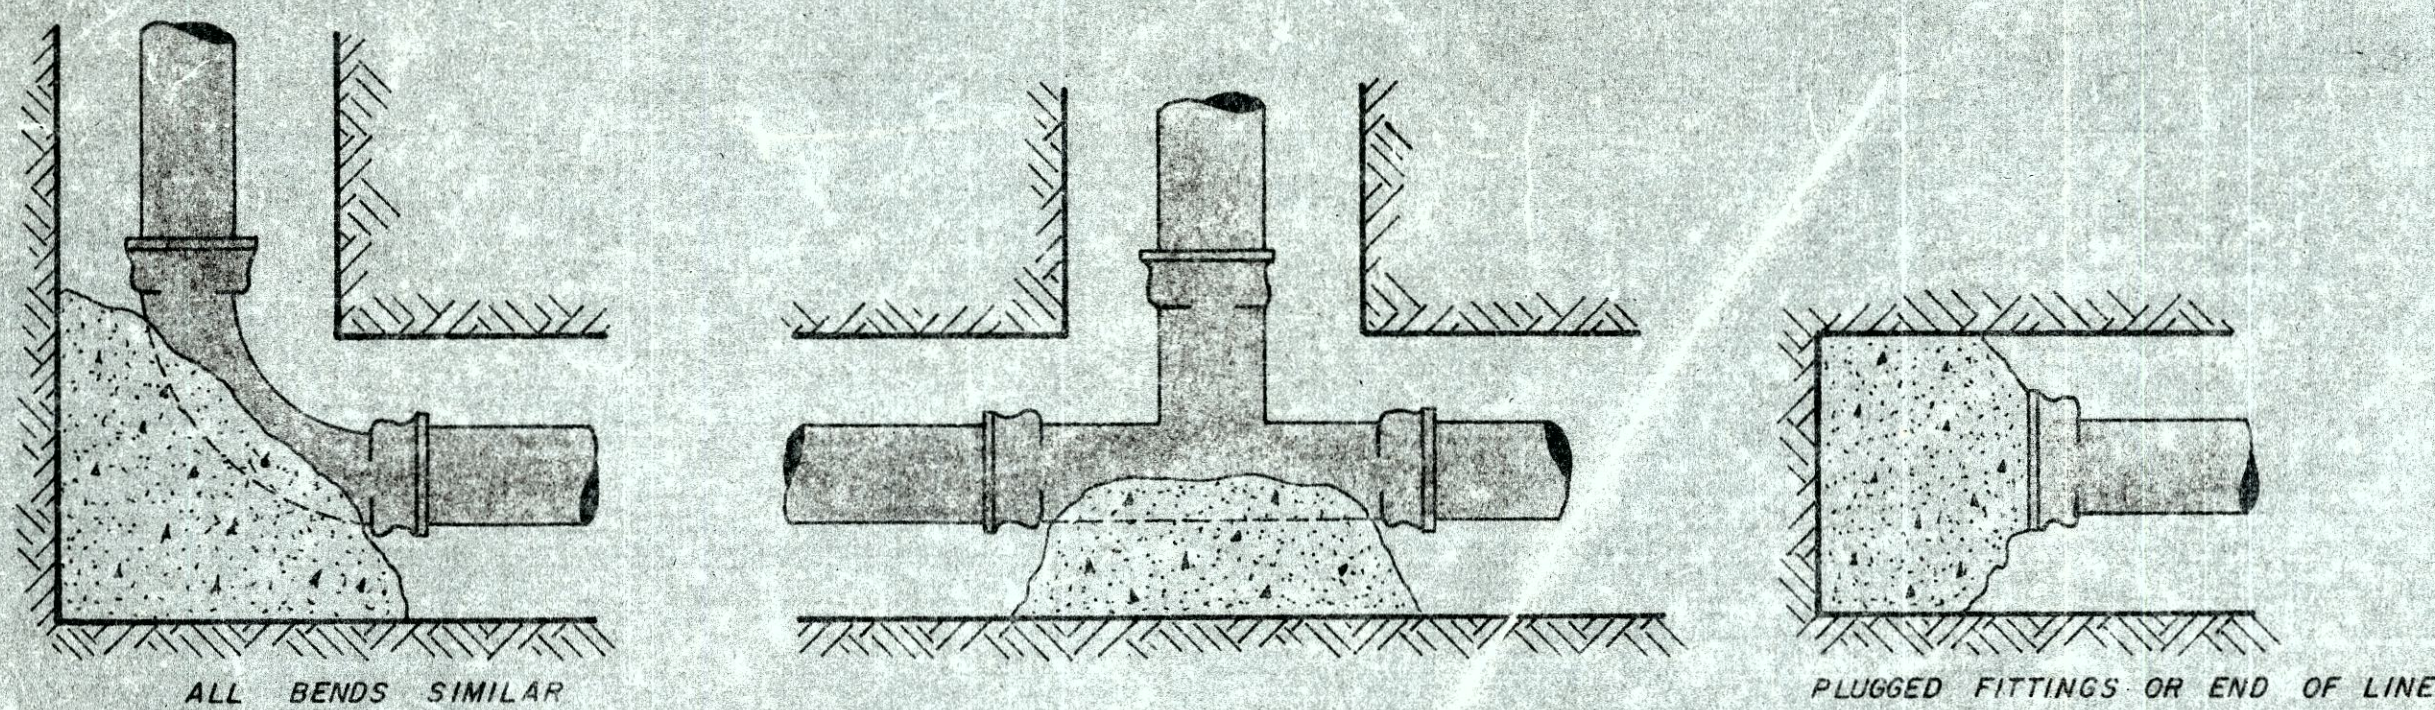


TYPICAL CONCRETE BACKING DETAILS FOR FITTINGS
(NOT TO SCALE)

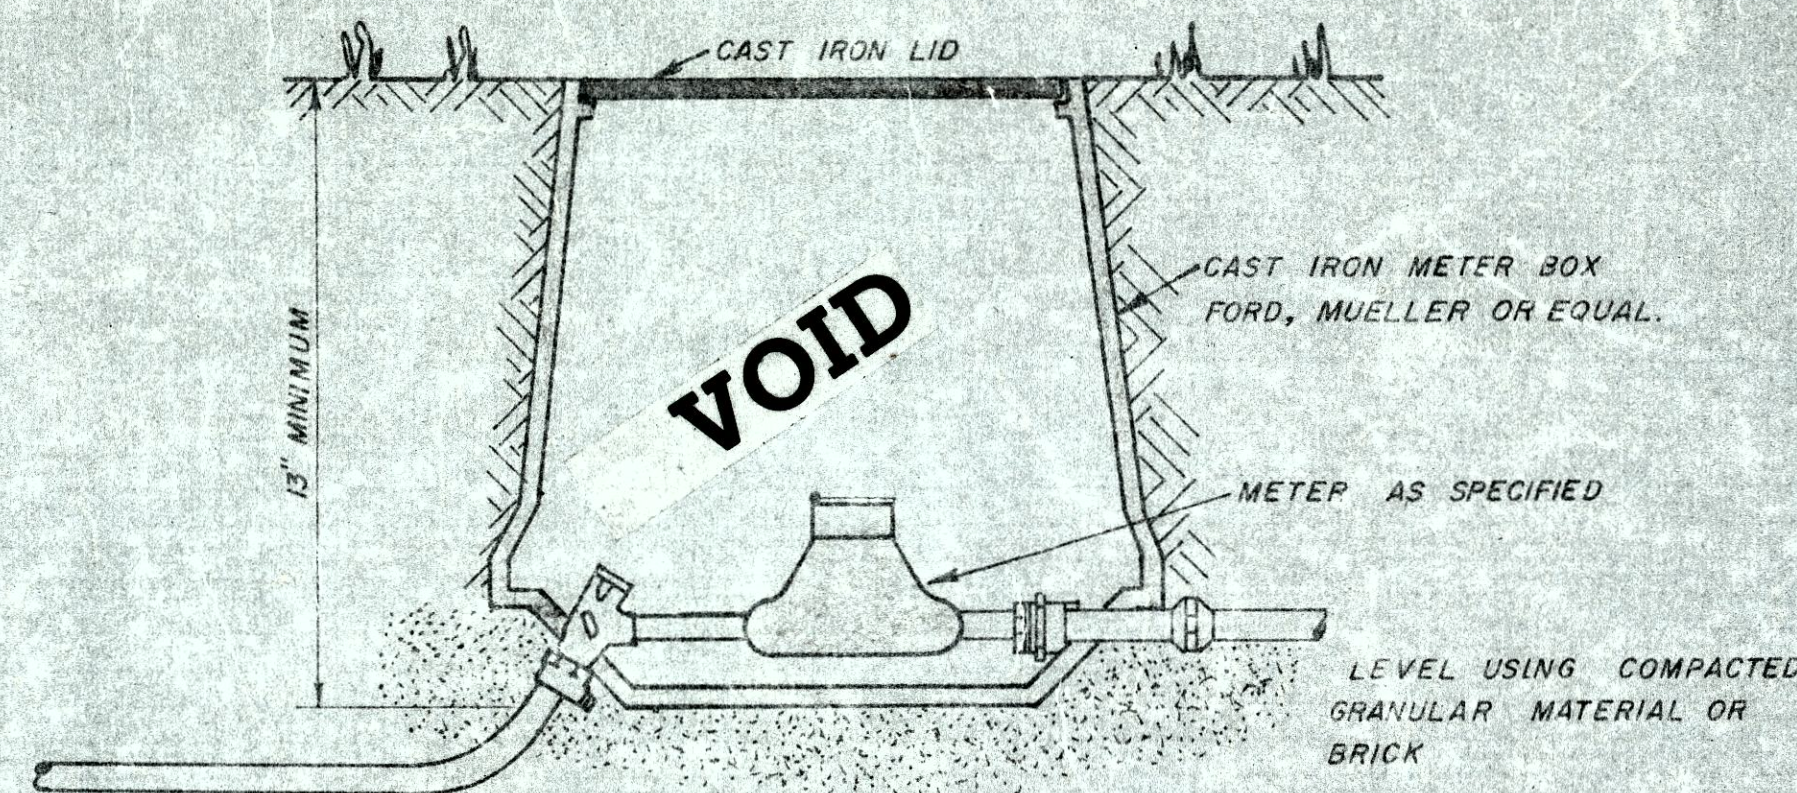


CAST IRON METER BOX SETTING DETAILS
(NOT TO SCALE)

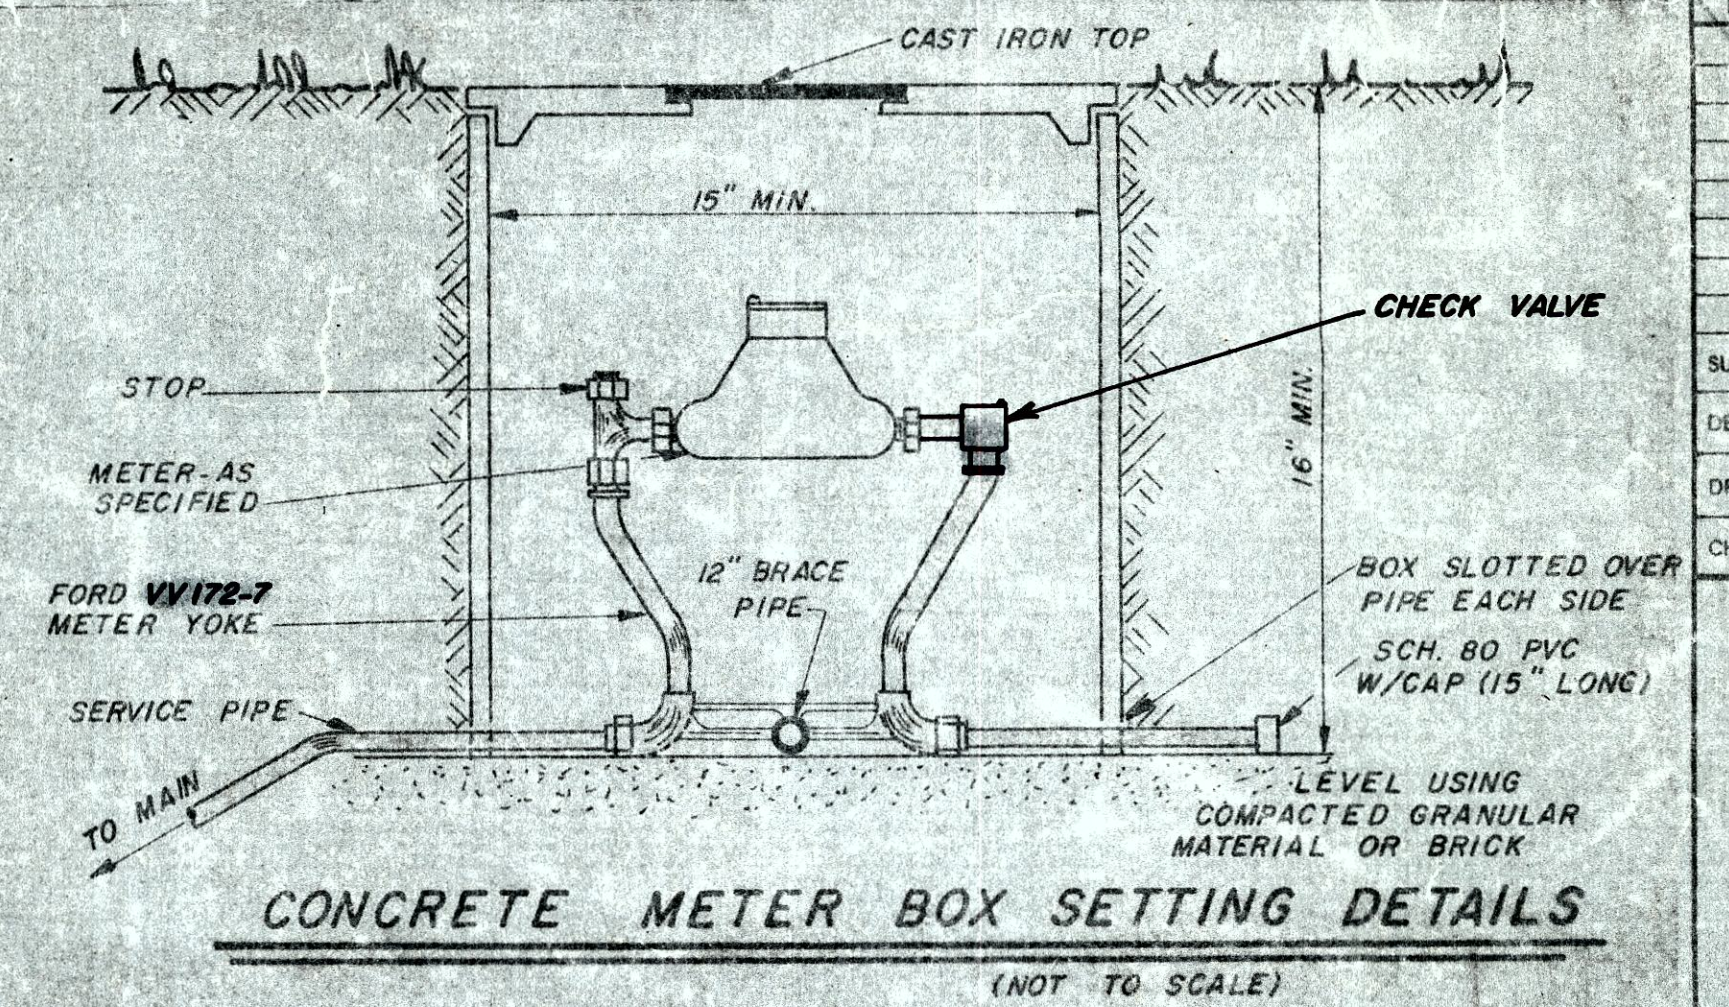


CONCRETE METER BOX SETTING DETAILS
(NOT TO SCALE)

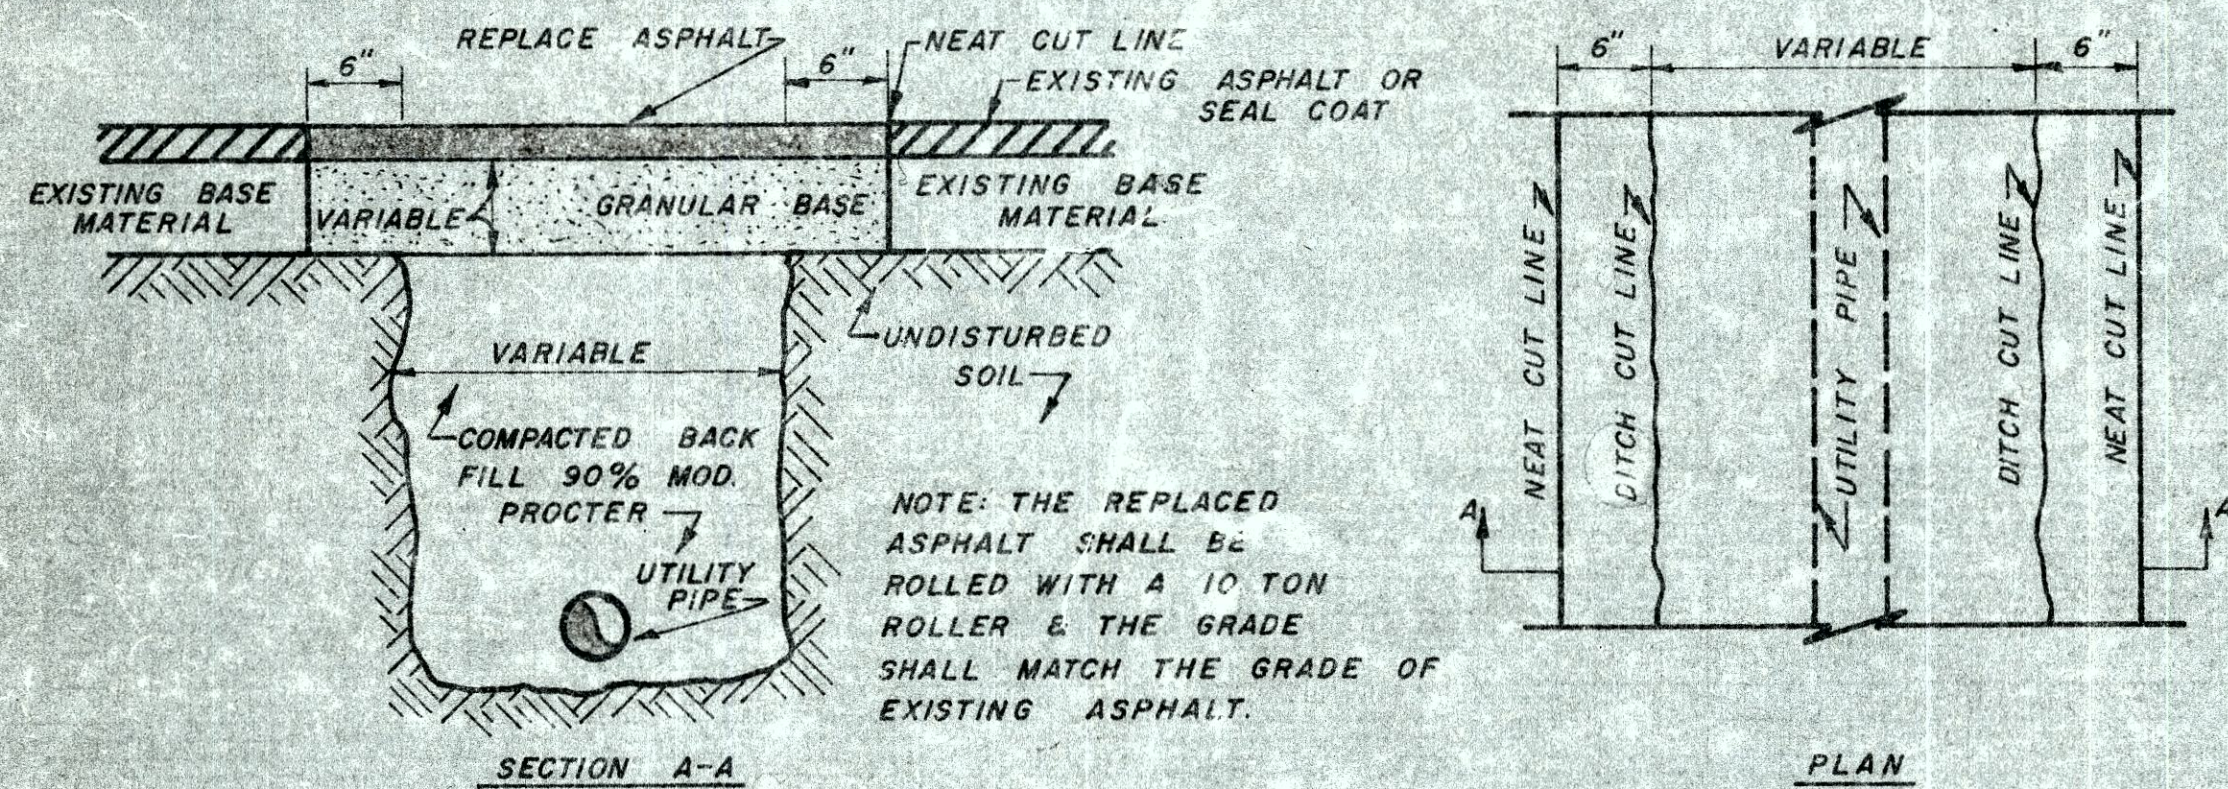


CITY STREET UTILITY CUT-REPAIR DETAIL
(NOT TO SCALE)

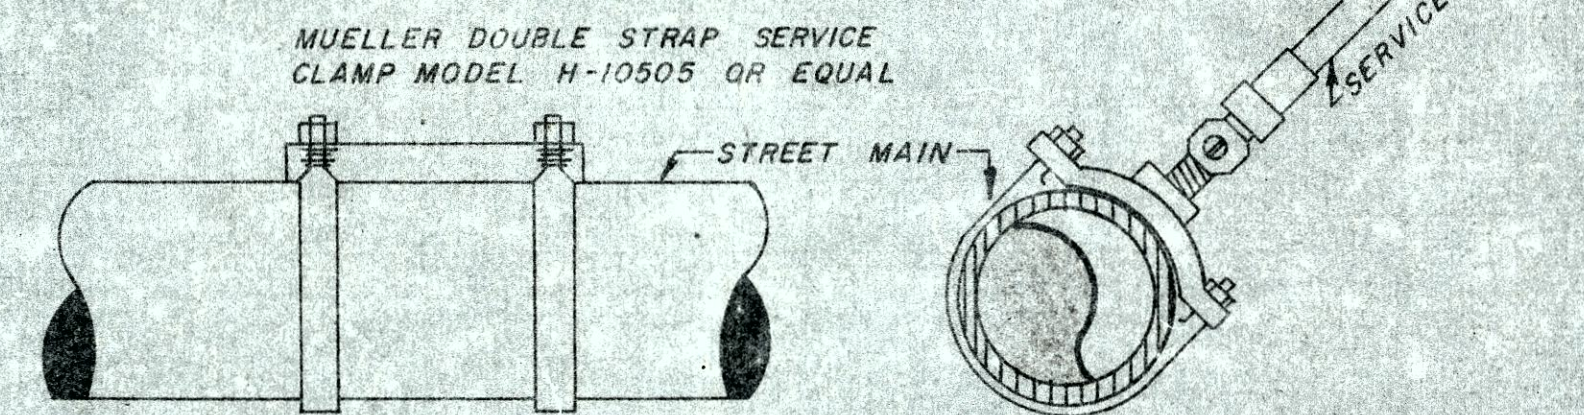



TYPICAL WATER SERVICE CONNECTION
(NOT TO SCALE)

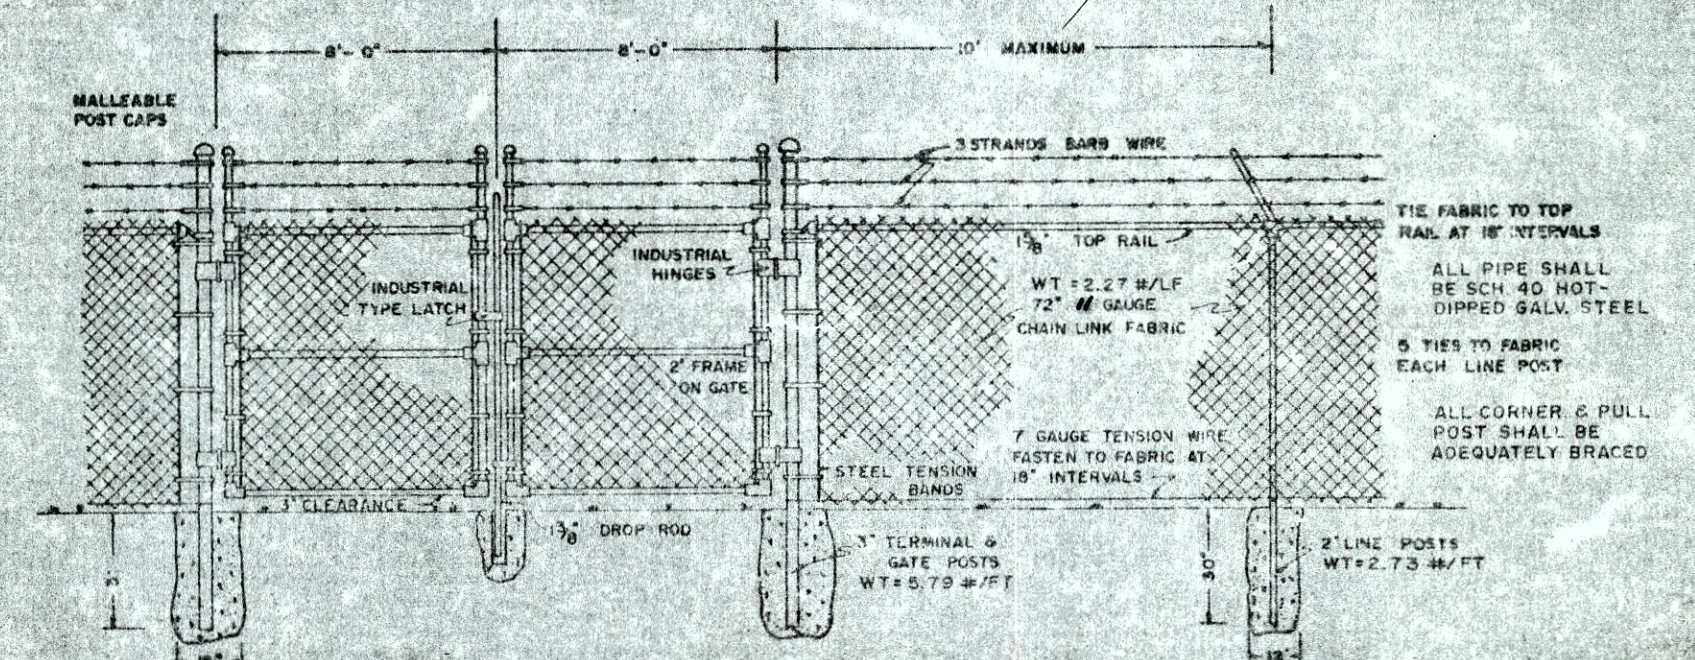


CHAIN LINK FENCE & GATE DETAIL
(NOT TO SCALE)

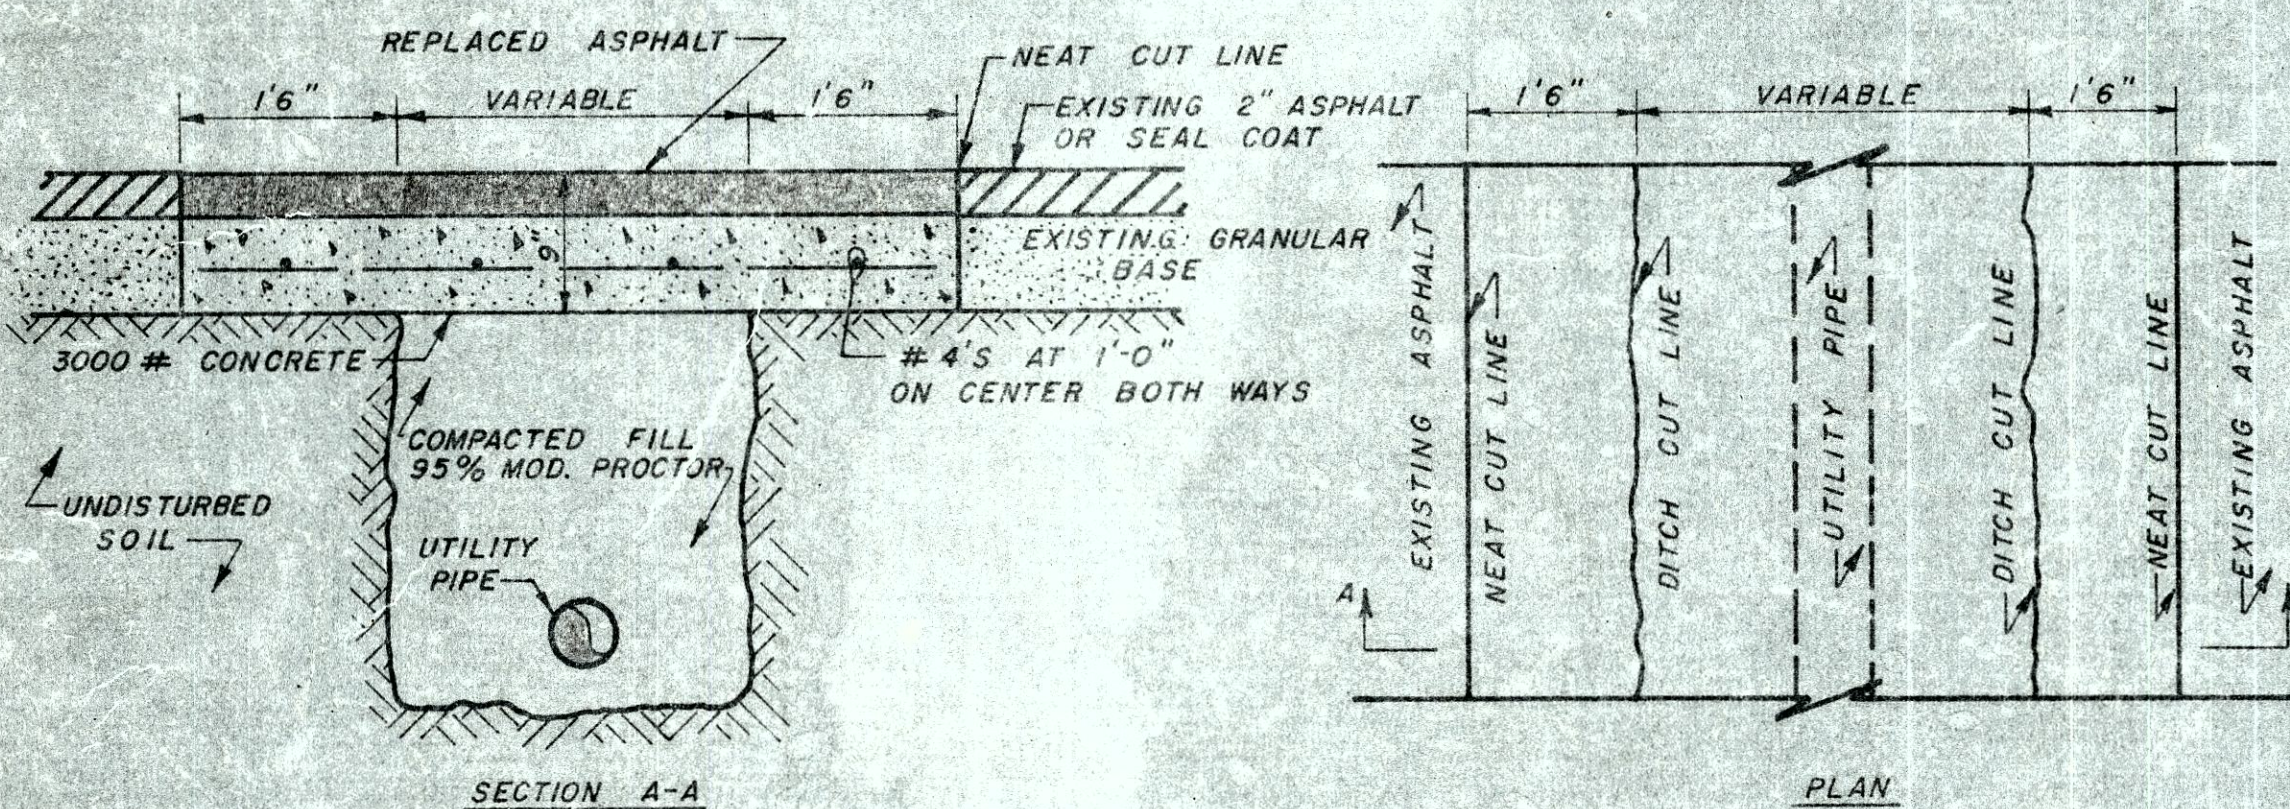


STATE HIGHWAY UTILITY CUT-REPAIR DETAIL
(NOT TO SCALE)

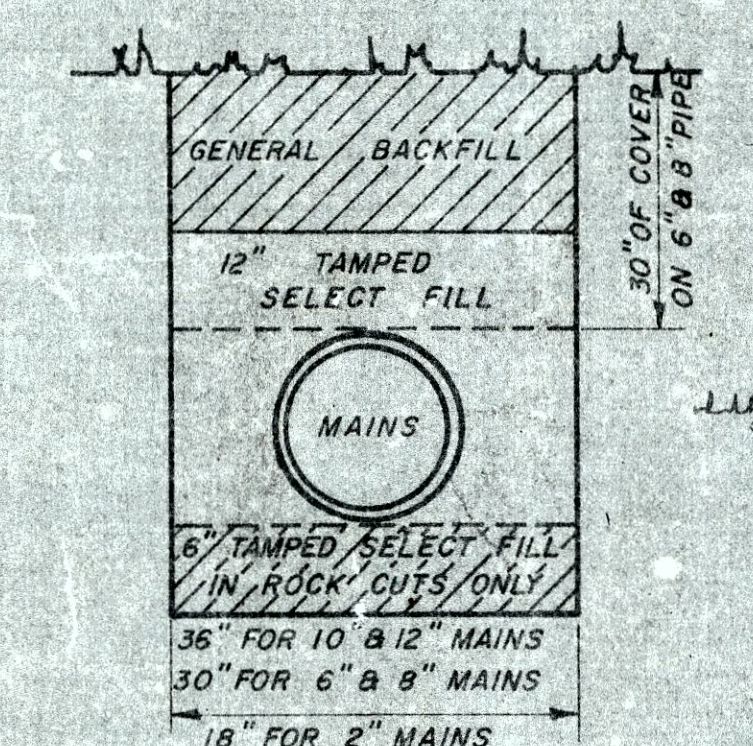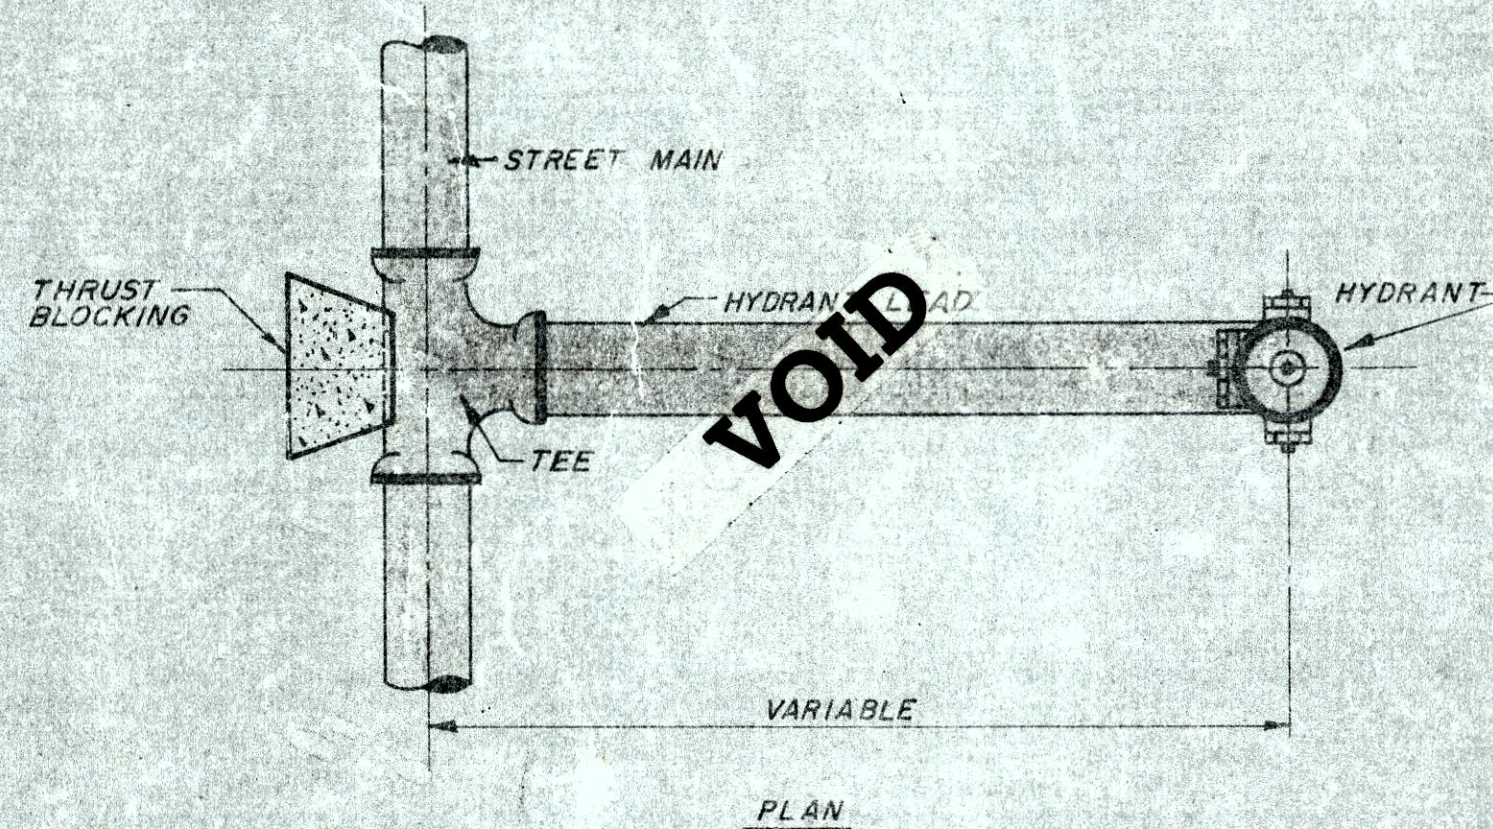


TYPICAL WATER TRENCH
(NOT TO SCALE)

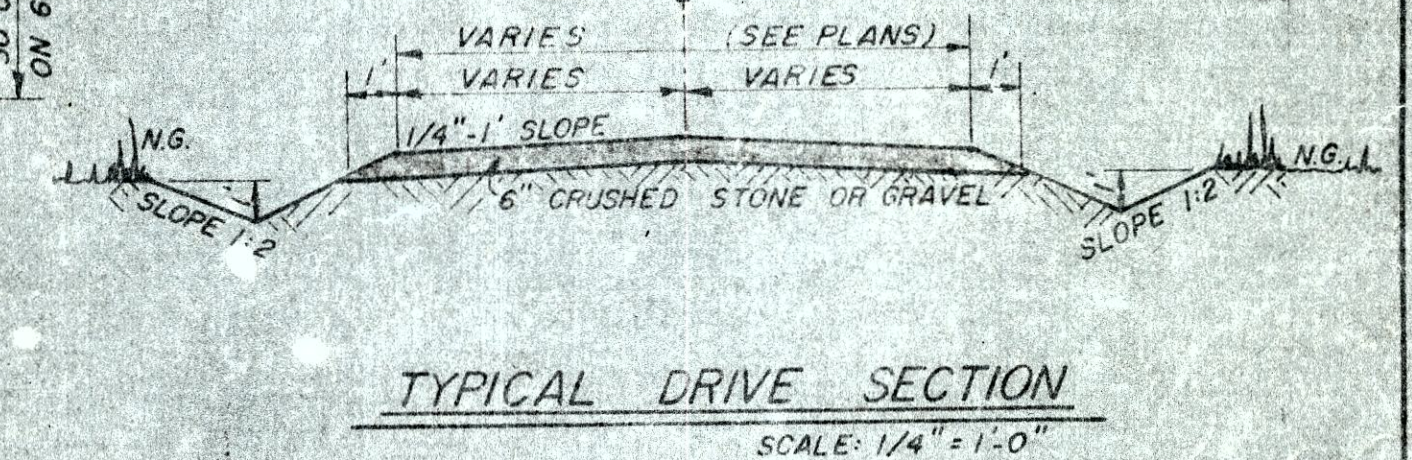


TYPICAL DRIVE SECTION
SCALE: 1/4" = 1'-0"

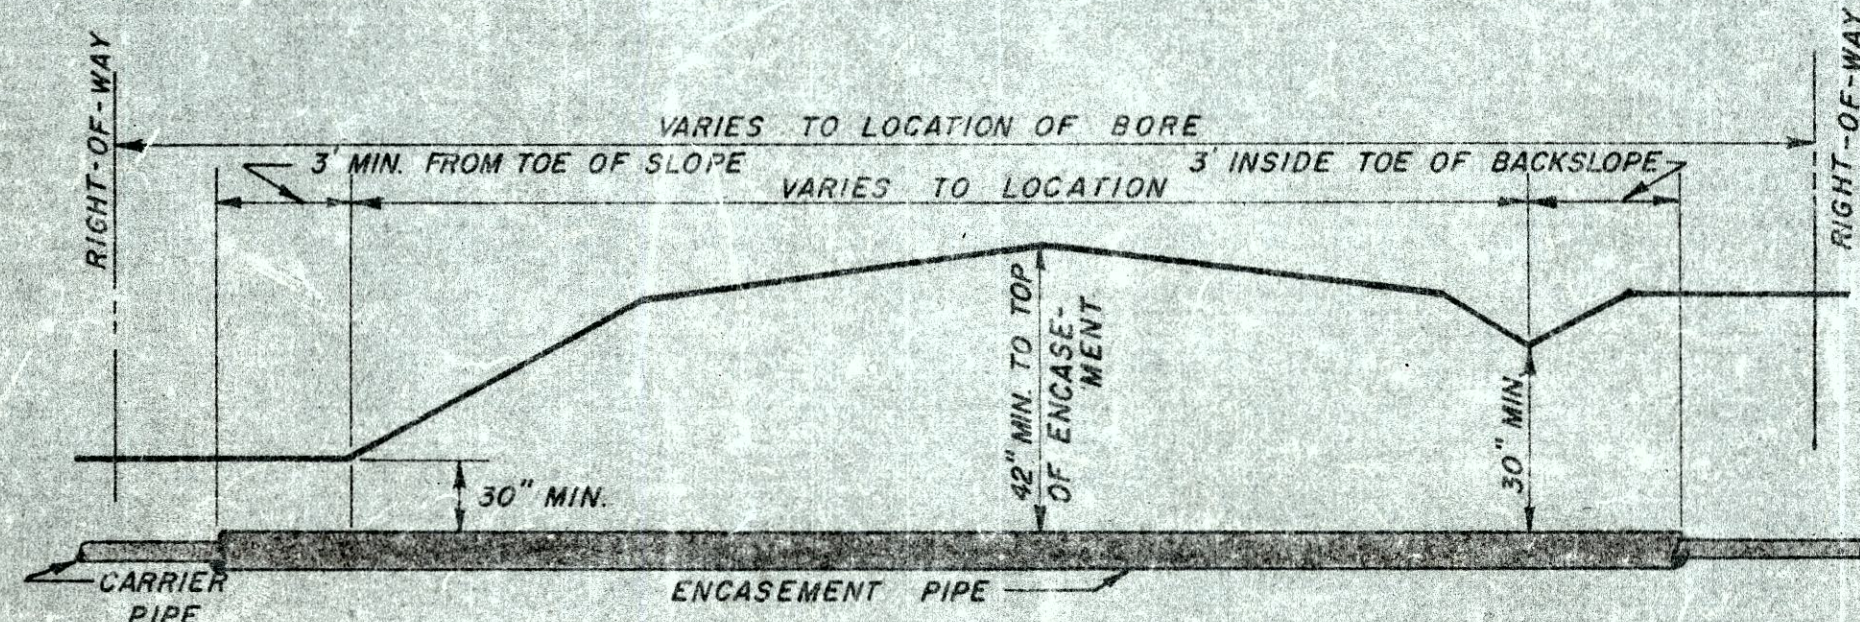

TYPICAL HIGHWAY BORING SECTION
(NOT TO SCALE)

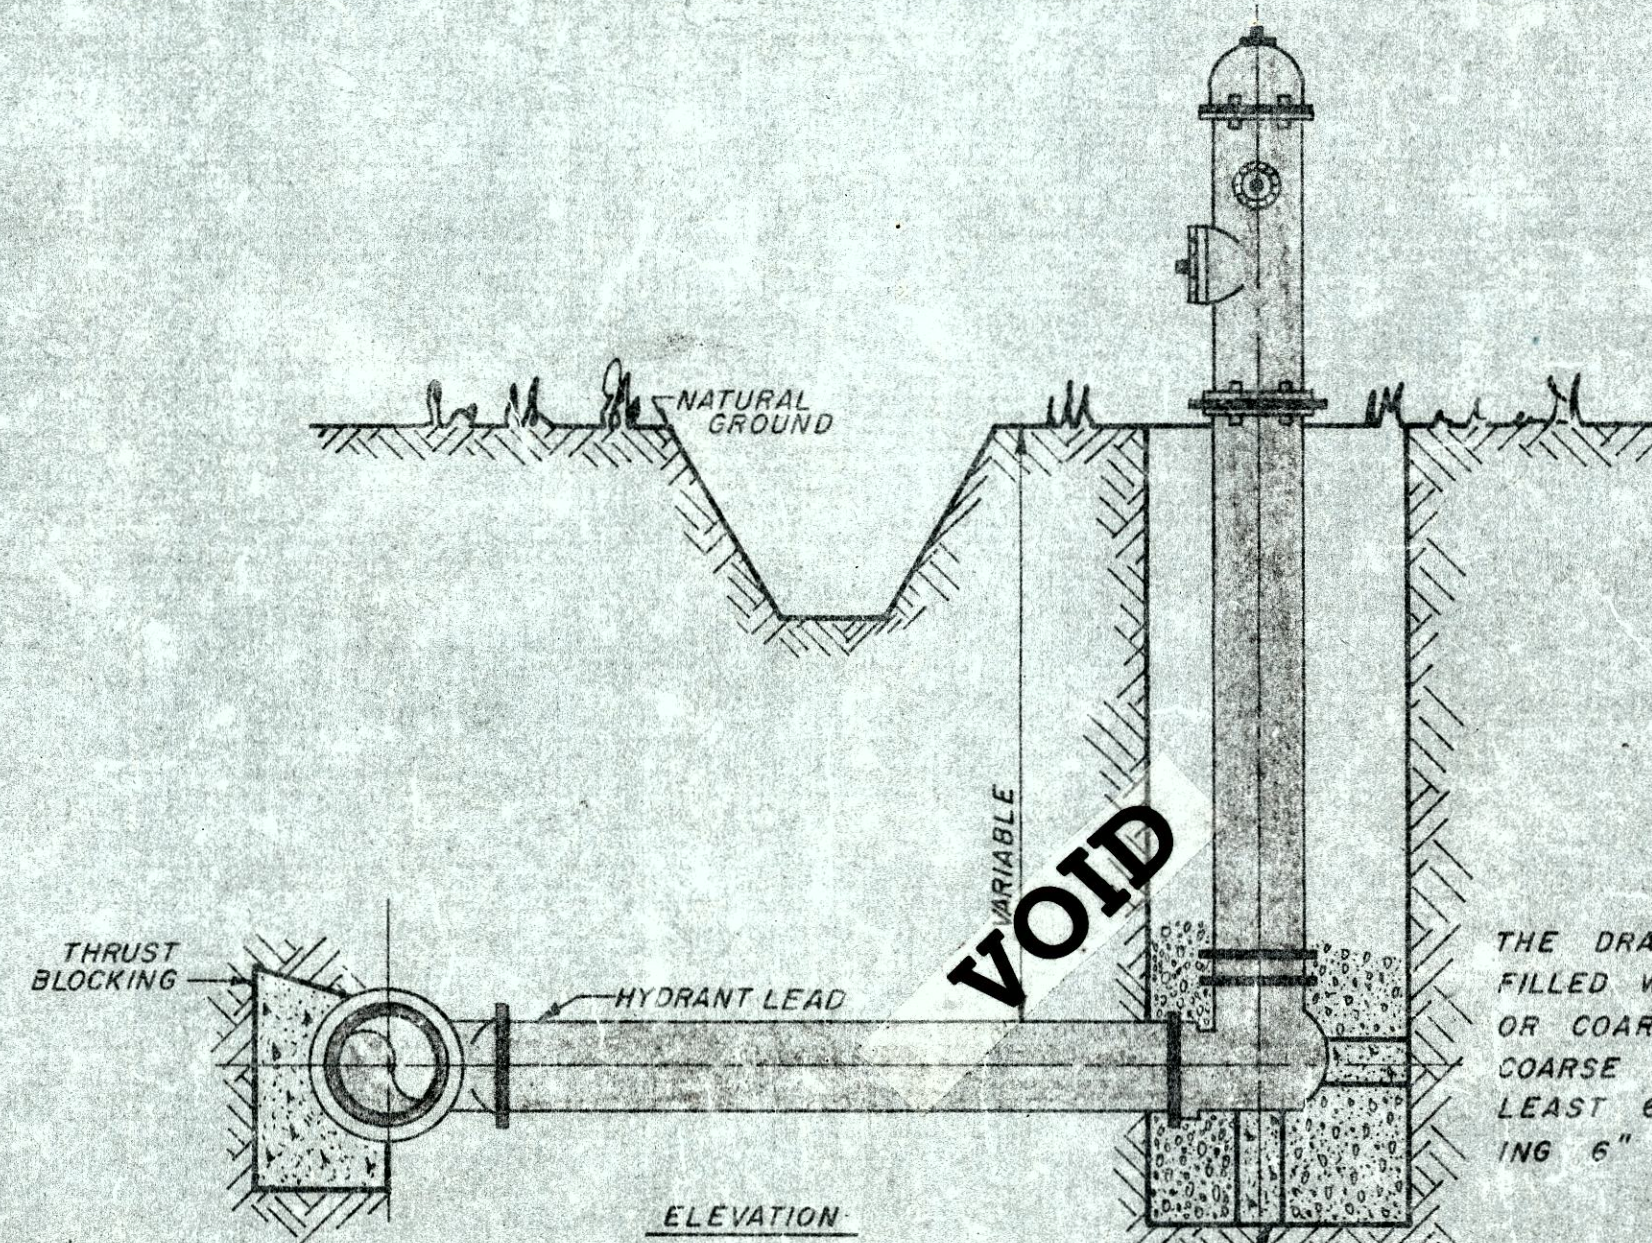


FIRE HYDRANT SETTING DETAIL
(NOT TO SCALE)

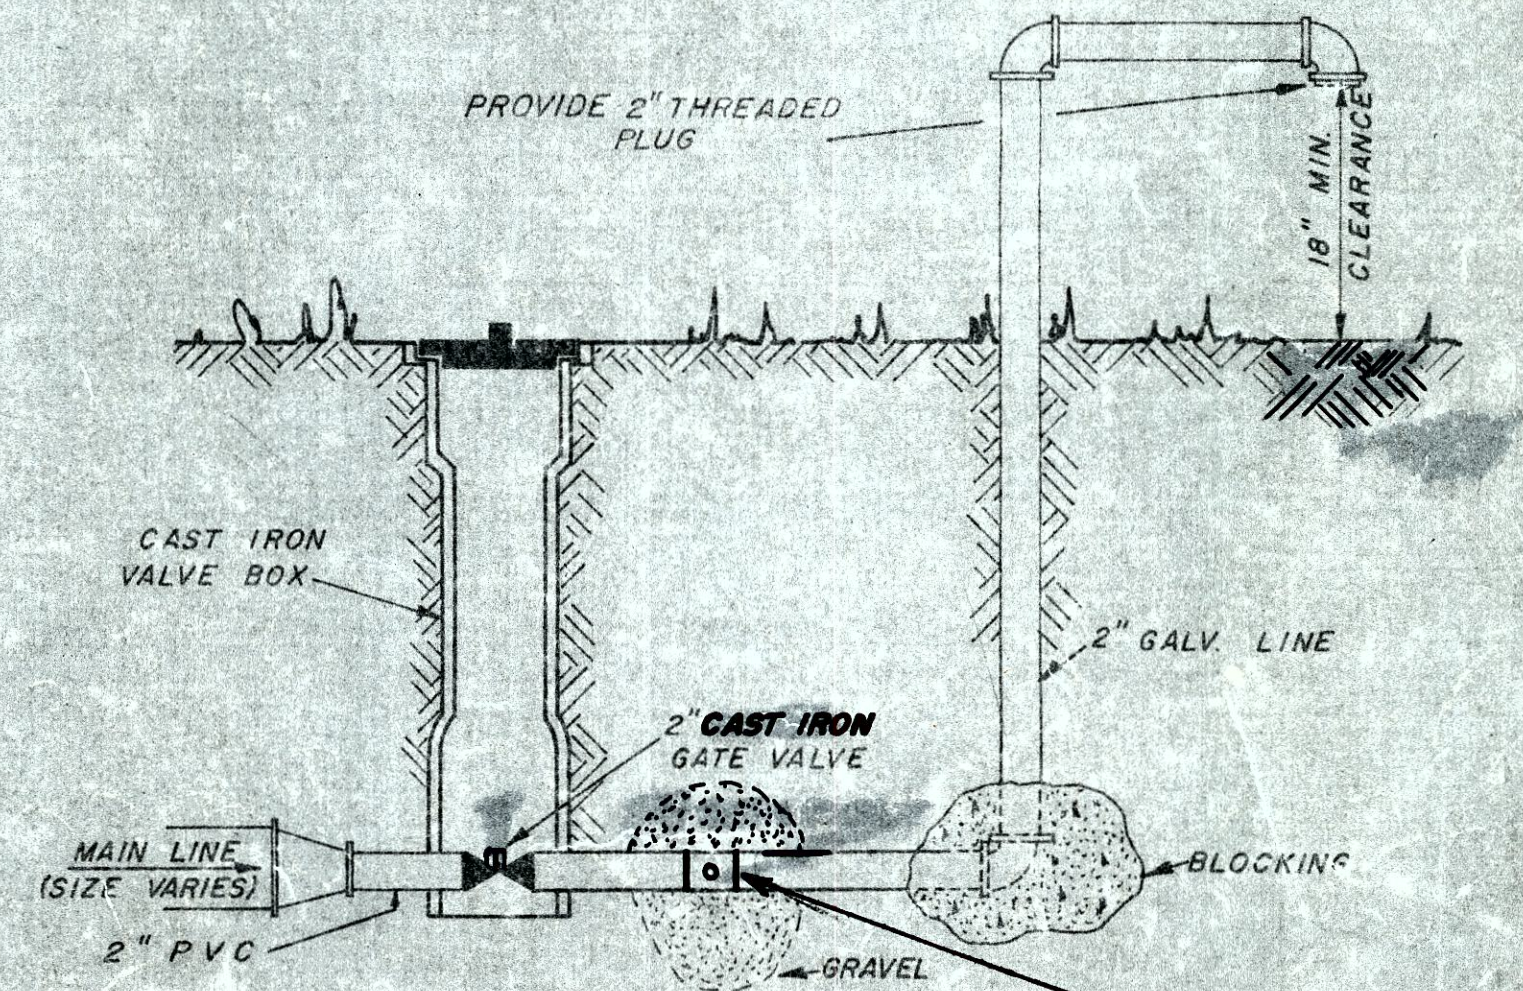

BLOW-OFF DETAIL
(NOT TO SCALE)

MT. SHERMAN WATER ASSOCIATION
NEWTON COUNTY, ARKANSAS

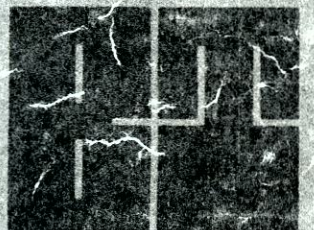

BLAYLOCK, THREET & ASSOCIATES, INC.
Consulting Engineers

MECHANICAL-ELECTRICAL
CIVIL SURVEYING
2306 CANTRELL ROAD
LITTLE ROCK, ARKANSAS



SCALE
AS SHOWN

DATE PROJECT NO.

APR 1982 80 055 2

SHEET **29** OF **29**

RECORD DRAWING
DATE Jan. 9, 1984