


NOTE: CONNECT ENCLOSURE TO A GOOD EARTH GROUND

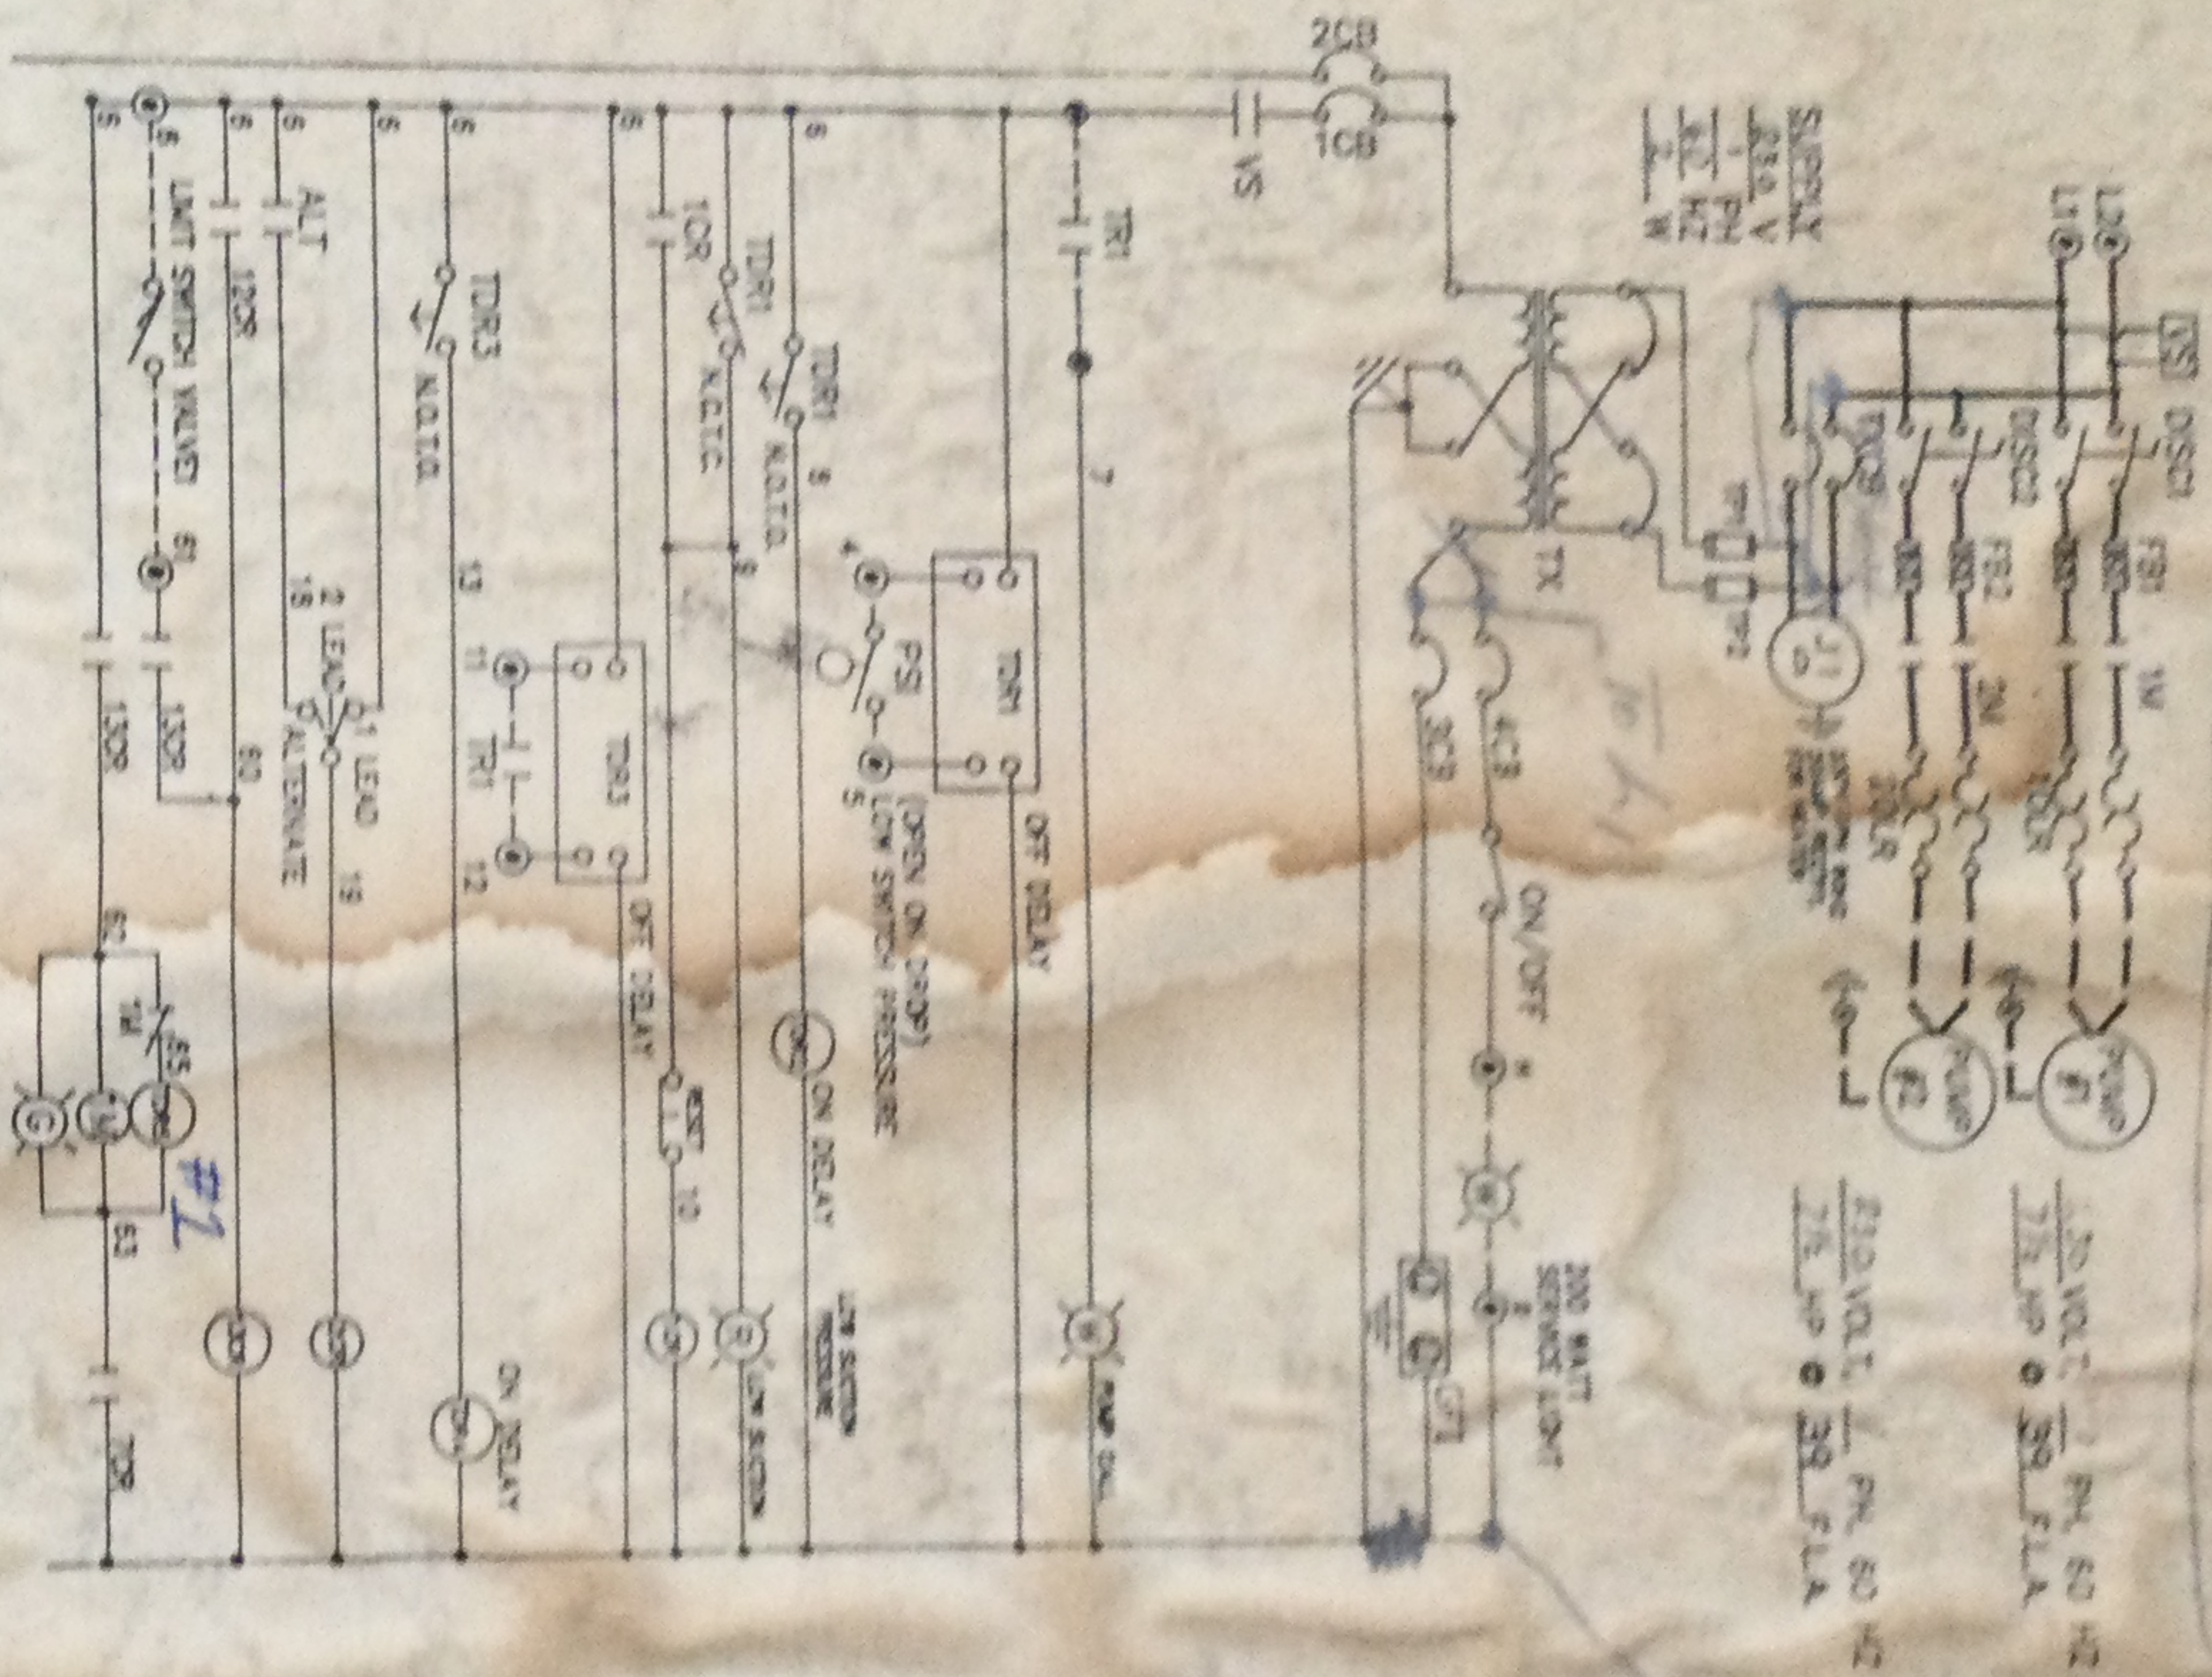

AS BUILT

MORAN MANUFACTURING INC. P. O. Box 1254 • Conway, Arkansas 72032 (501) 327-6561		TITLE <u>WATER BOOSTER CONTROLS</u> (1 st) PROJECT <u>MT. SHEPHERD</u> JOB NO. <u>7300-0004</u> P.O. NO. <u>10409</u> Dwg. No. <u>73-0004</u>		 DATE <u>5-2-82</u> REVISED: REVISED: REVISED:	
CUSTOMER: <u>I. S. I.</u>					