



GERALD
DANIELS
(Rent House)

NOTE:
THE CONTRACTOR SHALL BE RESPONSIBLE FOR
DETERMINING EXACT LOCATIONS OF EXISTING
UTILITIES.

MAIN A

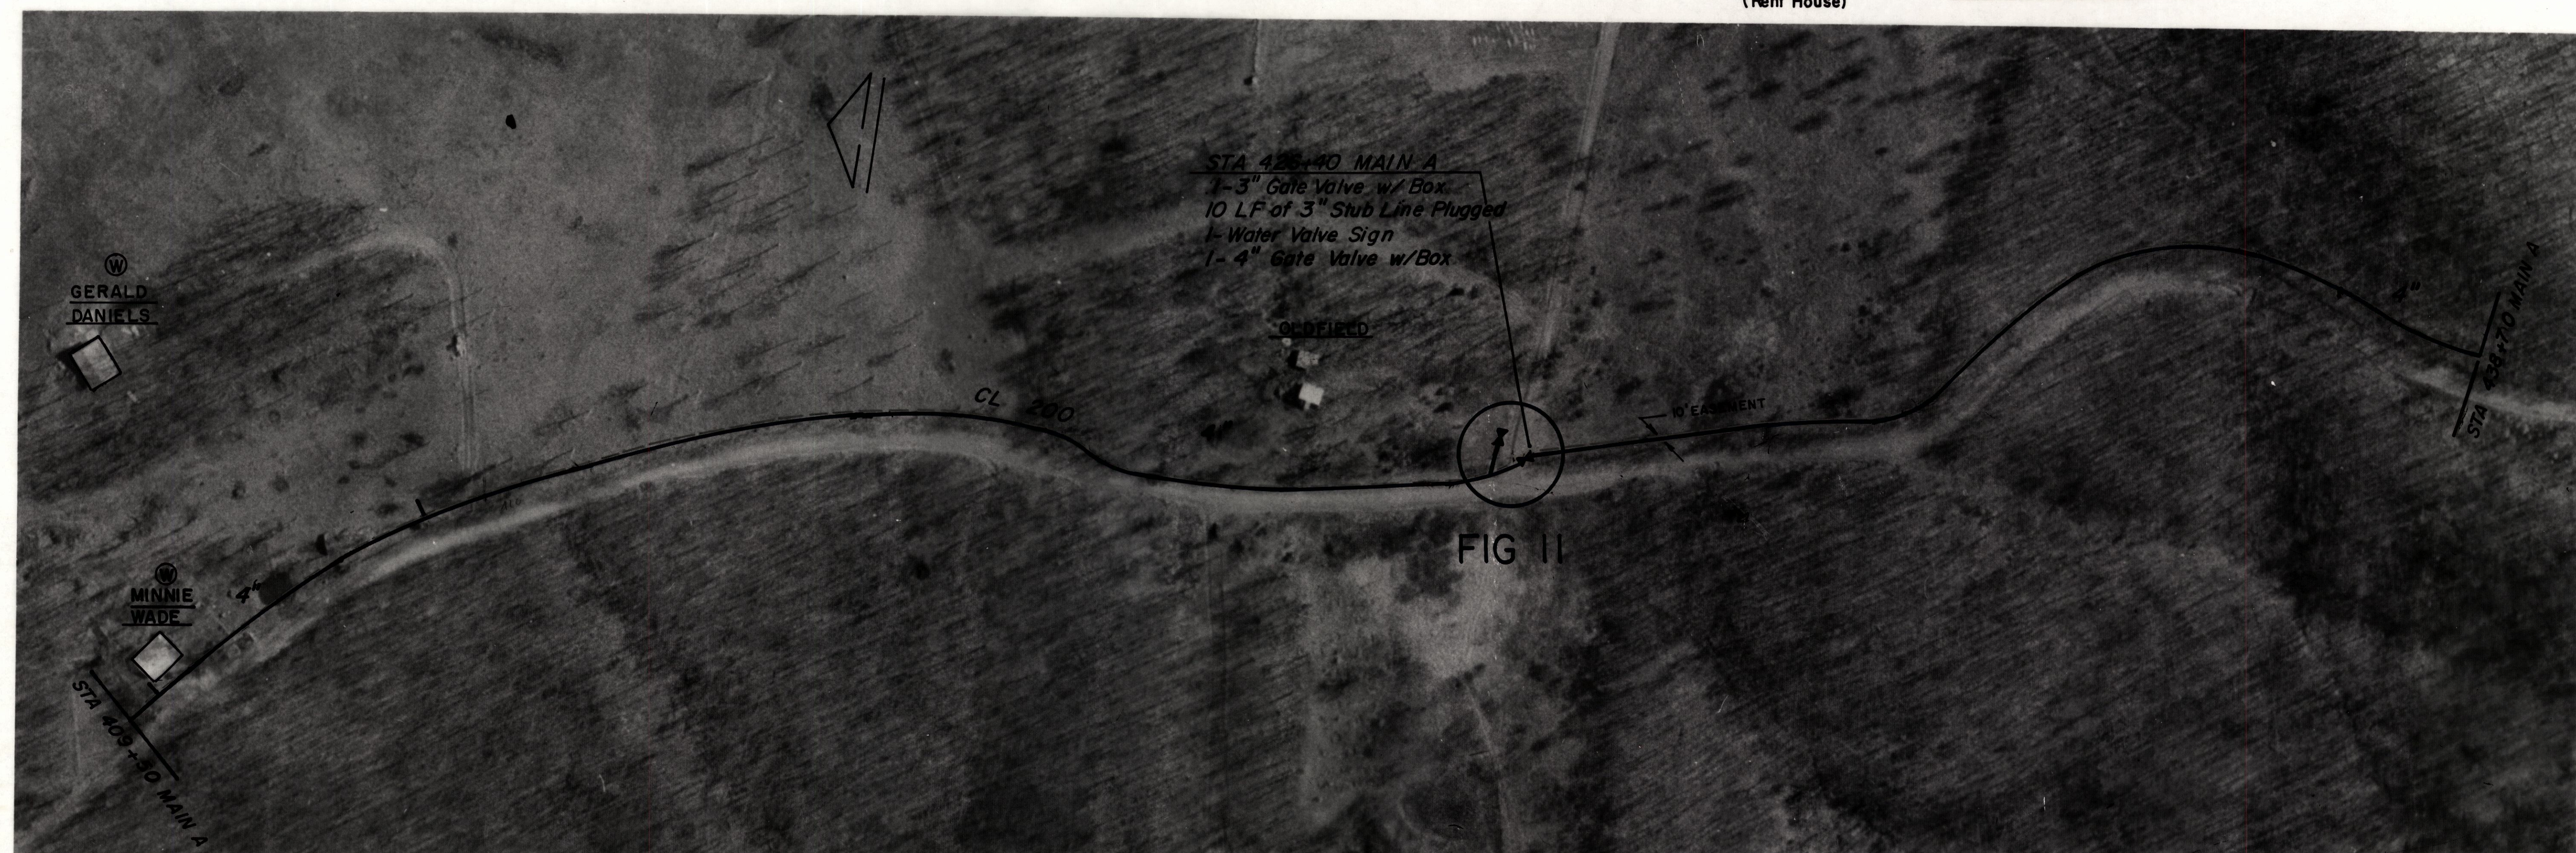
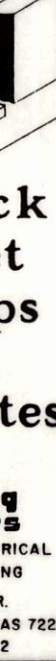
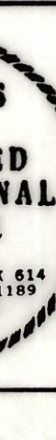


FIG 1

RECORD DRAWING
OCT 1988

MAIN A

	DATE	REVISIONS
SURVEY BY: AHTD		
DESIGN BY: CJM		
DRAWN BY: RAH		
CHECKED BY: RWT		
MT. SHERMAN WATER ASSOCIATION		
WATER SYSTEM IMPROVEMENT FOR		
MAIN A		
NEWTON COUNTY ARKANSAS		
 Blaylock Threet Phillips and Associates Inc. consulting engineers MECHANICAL - ELECTRICAL CIVIL - SURVEYING 1501 MARKET DR. LITTLE ROCK, ARKA 72201 501-224-3922		
 STATE OF ARKANSAS REGISTERED PROFESSIONAL ENGINEER RAYMOND E. BLAYLOCK #14 ROBERT W. THREET #159 JAMES M. PHILLIPS #282		
SCALE		
1" = 100' - 0"		
DATE	PROJECT NO.	
JULY 1987	87 040 2	
SHEET 10	OF	19