




EXT A-1

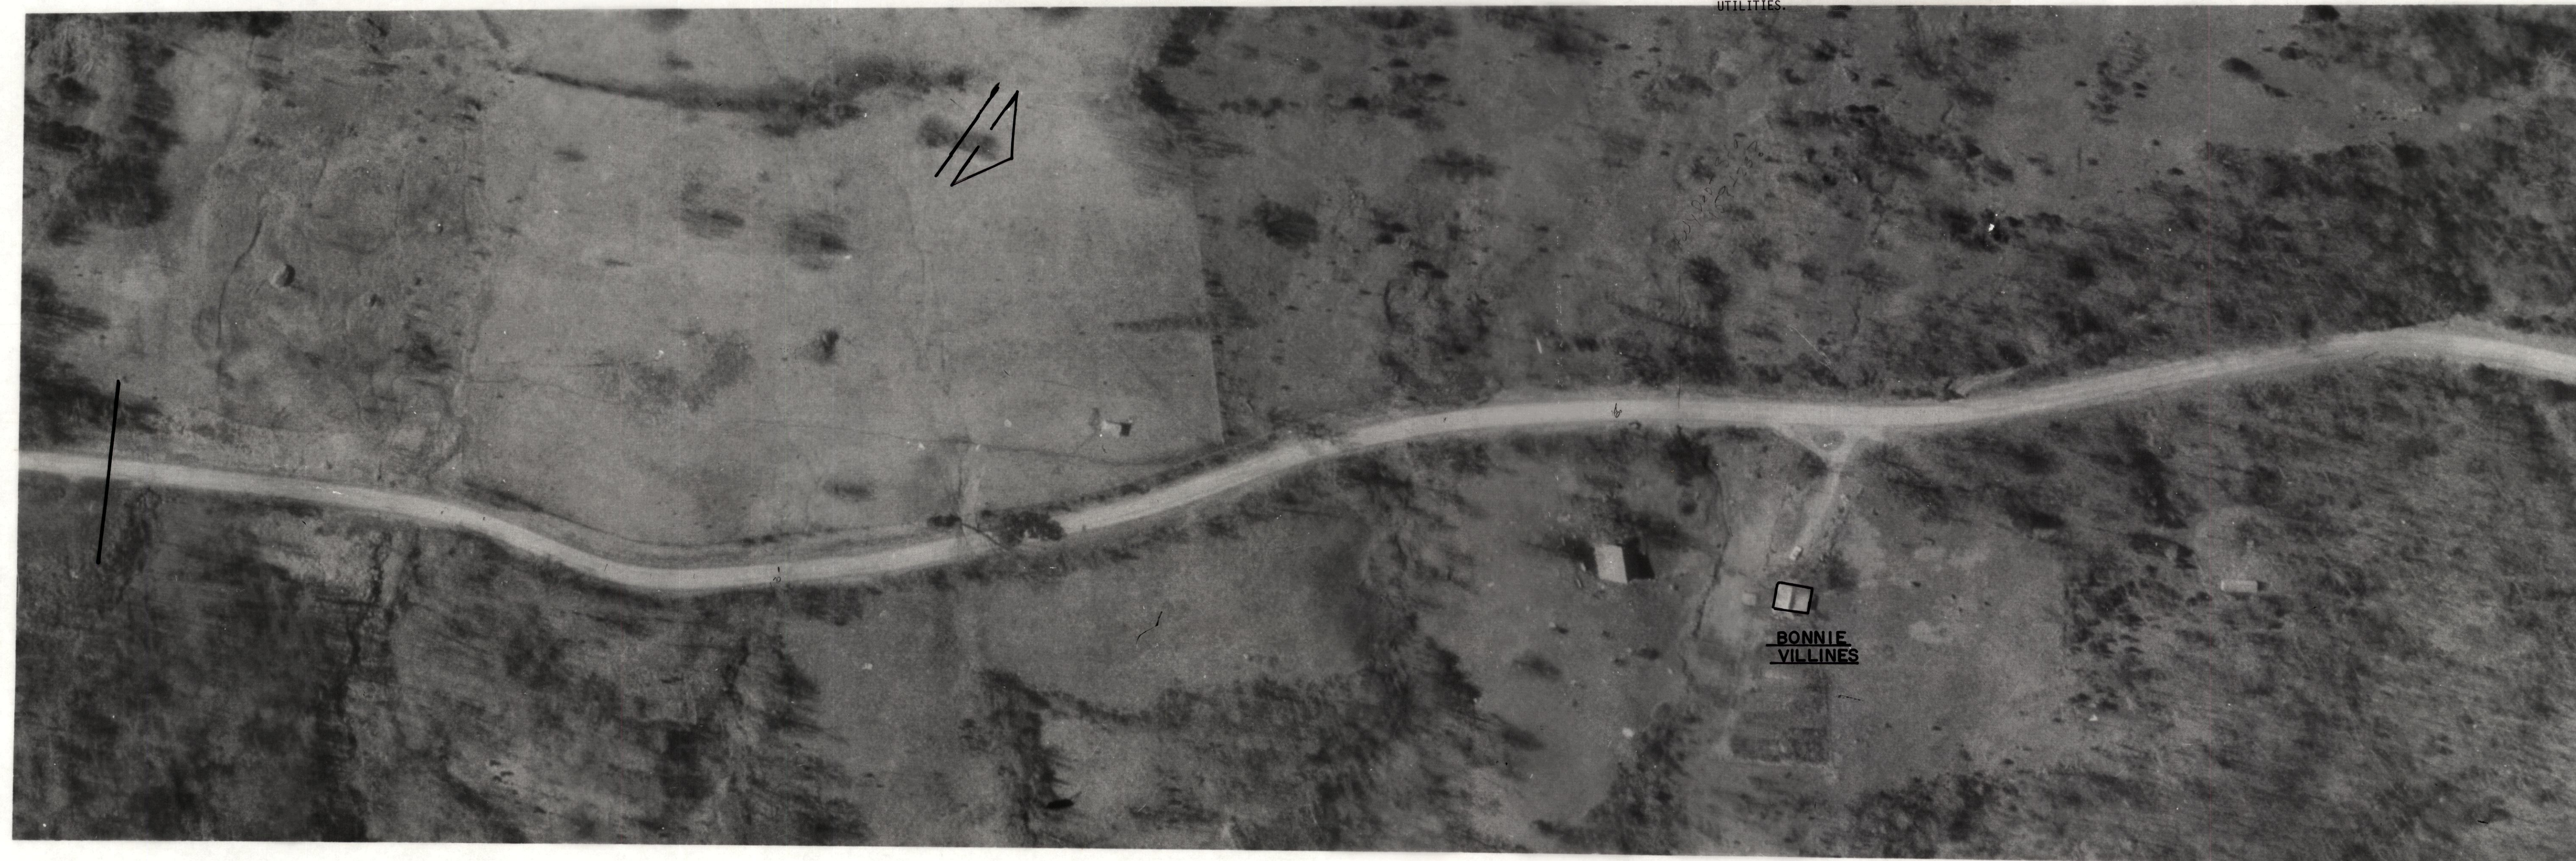

EXT A-1

RECORD DRAWING
OCT 1988



DATE	REVISIONS
SURVEY BY:	AHTD
DESIGN BY:	CJM
DRAWN BY:	RAH
CHECKED BY:	RWT

WATER SYSTEM IMPROVEMENT
FOR
MT. SHERMAN WATER ASSOCIATION

NEWTON COUNTY

ARKANSAS

EXT A-1

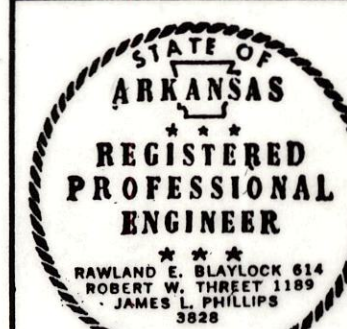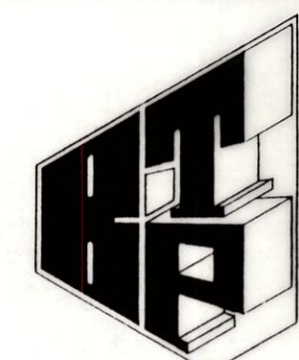

SCALE $1'' = 100' - 0''$	
DATE JULY 1987	PROJECT NO. 87 040 2
SHEET 13	OF 19