



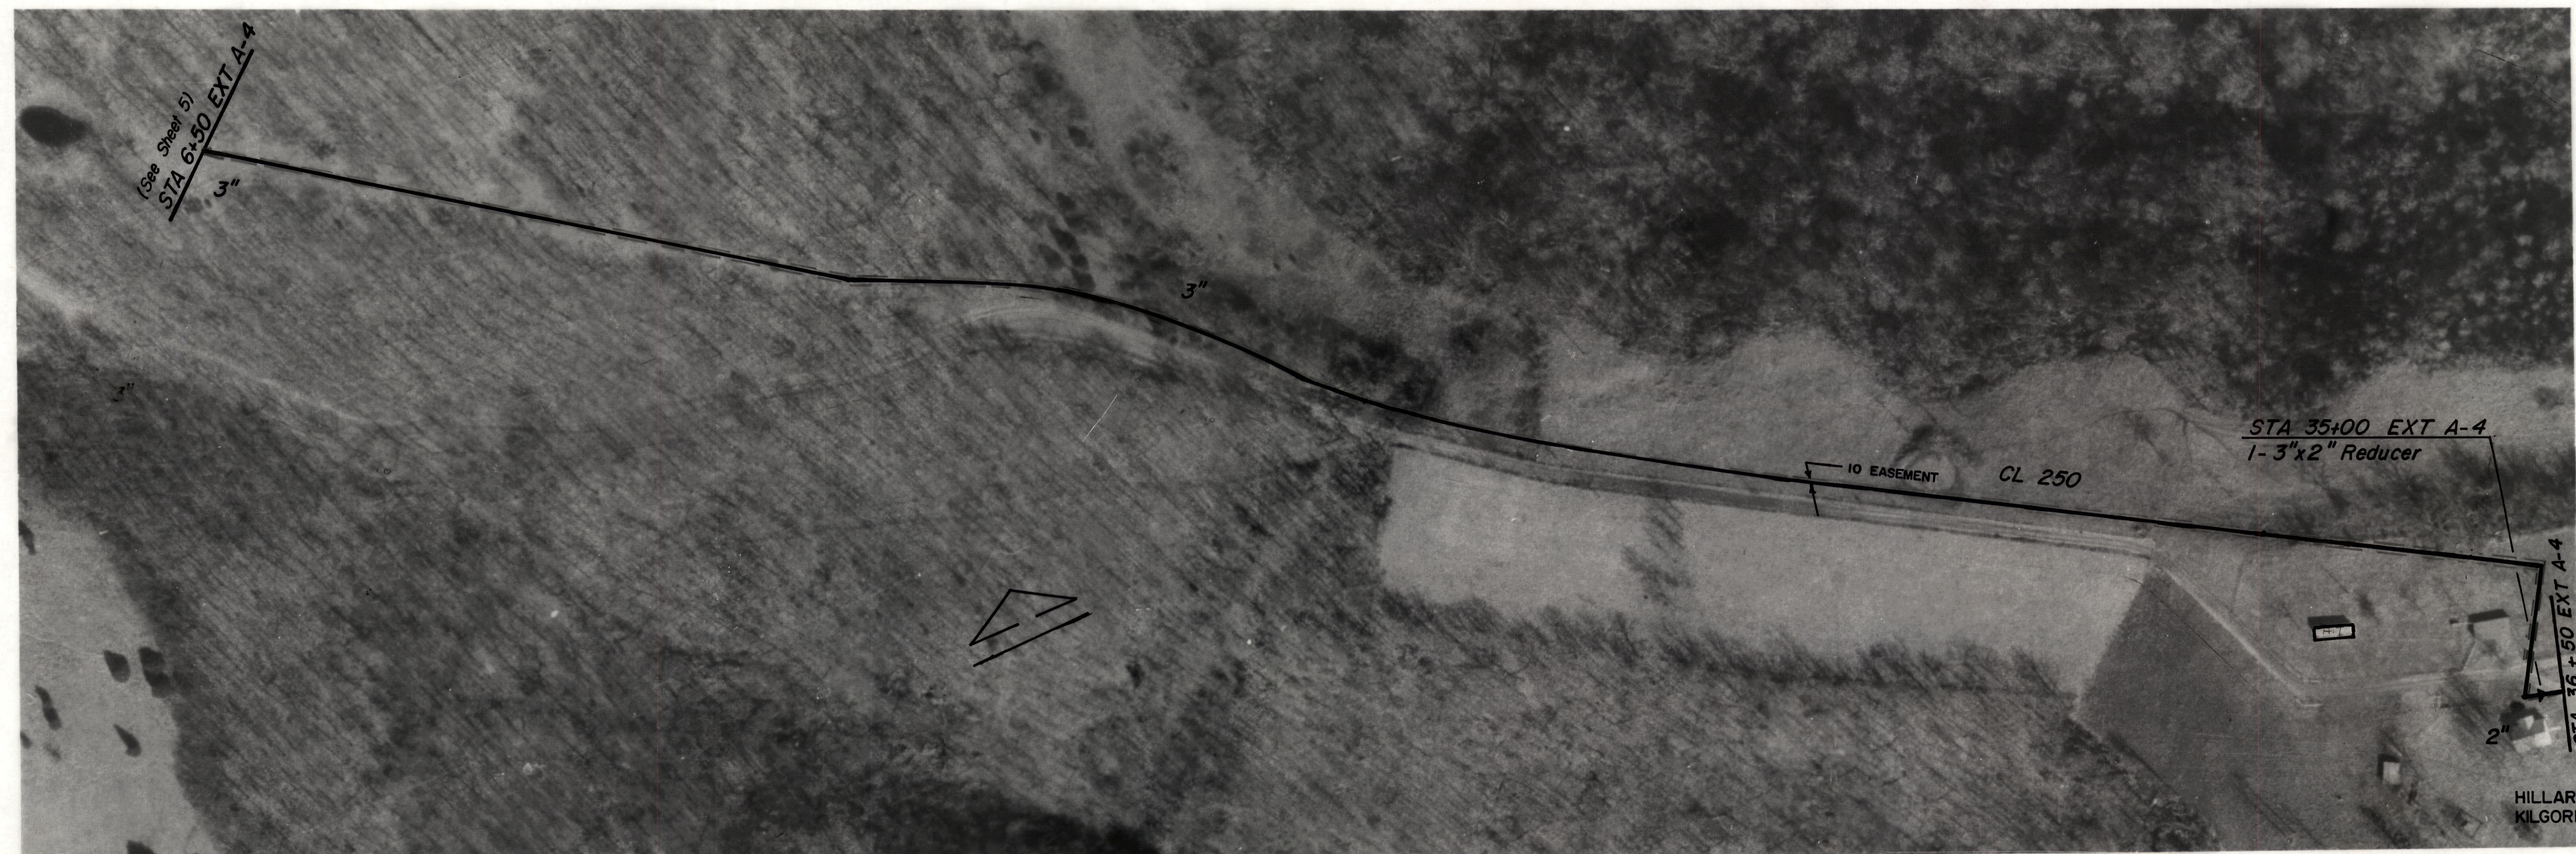

NOTE:
THE CONTRACTOR SHALL BE RESPONSIBLE FOR
DETERMINING EXACT LOCATIONS OF EXISTING
UTILITIES.

EXT A-4

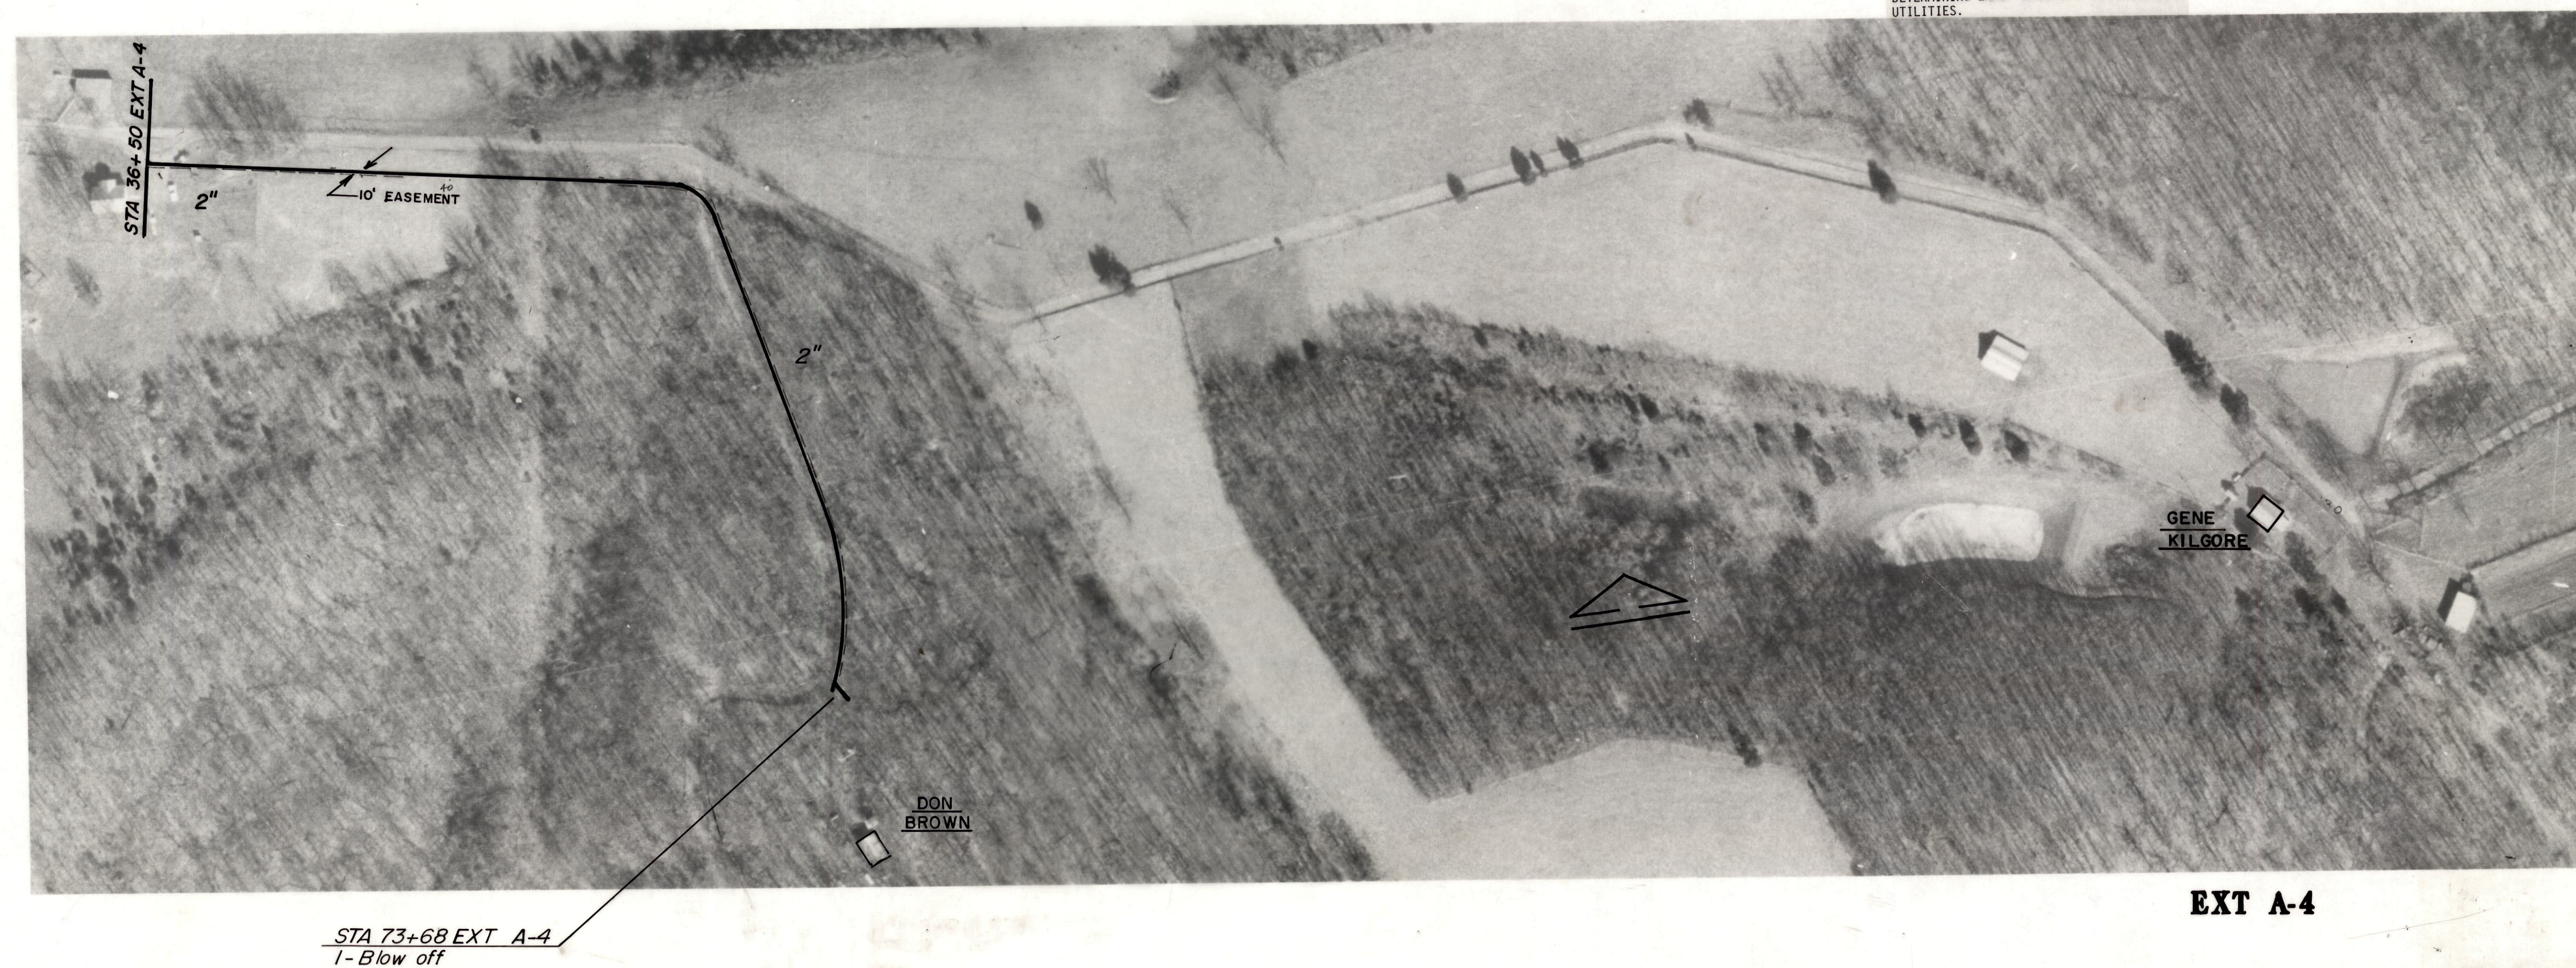

EXT A-4

RECORD DRAWING
OCT 1988

☐ ☐ LEE BYERS (0.9 Mile)
☐ TOM LEMASTER (1 Mile)

	DATE	REVISIONS
SURVEY BY:	AHTD	
DESIGN BY:	CJM	
DRAWN BY:	RAH	
CHECKED BY:	RWT	


**WATER SYSTEM IMPROVEMENT
FOR
MT. SHERMAN WATER ASSOCIATION**

NEWTON COUNTY ARKANSAS

EXT A-4



**Blaylock
Threet
Phillips
and
Associates
Inc.**
consulting engineers
MECHANICAL · ELECTRICAL
CIVIL · SURVEYING
1501 MARKET DR.
LITTLE ROCK, ARKANSAS 72201
(501) 224-3922

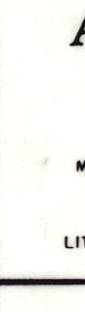

STATE OF ARKANSAS
REGISTERED PROFESSIONAL ENGINEER
No. 222
BAYLAND E. BLAYLOCK, P.E.
PHILIP T. THREET, P.E.
JAMES L. PHILLIPS, P.E.

SCALE
1" = 100' - 0"

DATE	PROJECT NO.
JULY 1987	87 040 2

SHEET **16**
OF **19**