

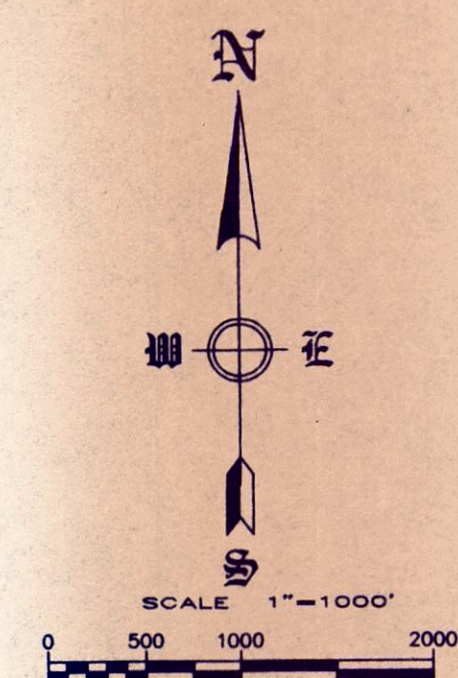


\\Server\WATER\Steel_Creek\asbuilt\199809-STEEL CREEK-G-asbuilt.dwg Thu Nov 09 10:15:31 2000

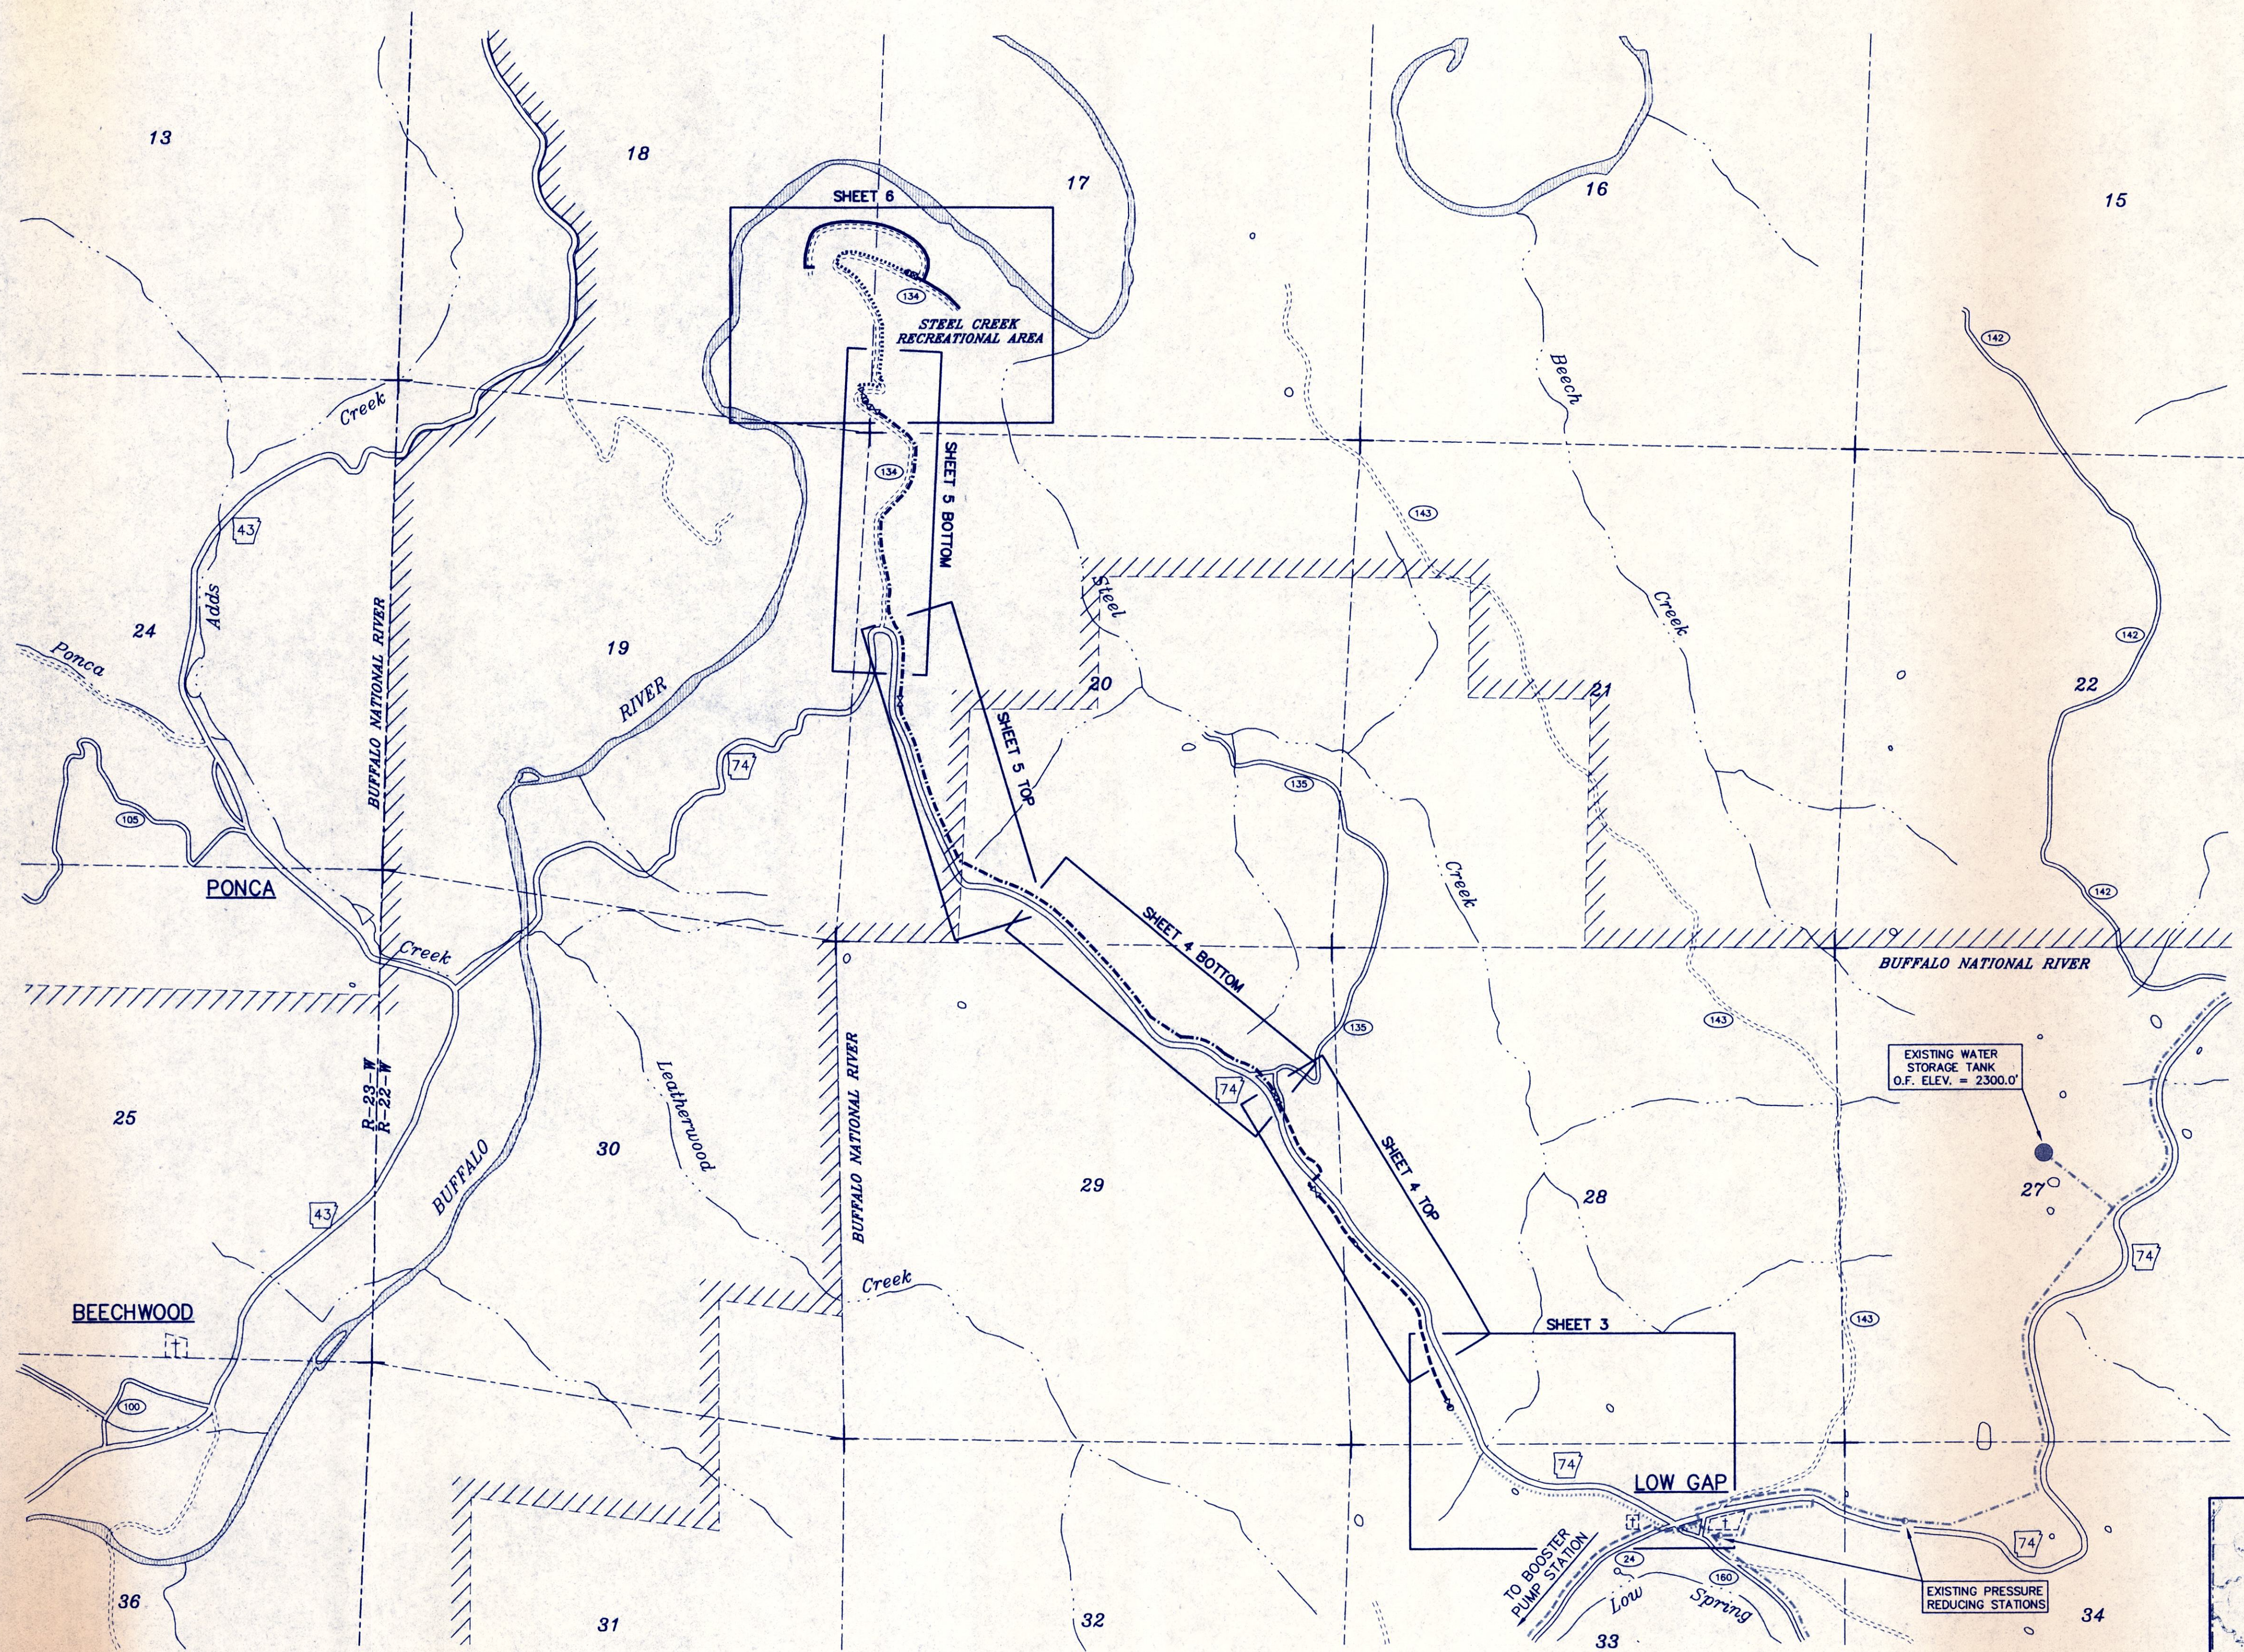

LEGEND	
	STATE HIGHWAY
	PAVED COUNTY ROAD
	GRAVEL COUNTY ROAD
	SECTION AND RANGE LINES
	CREEK
	STATE HIGHWAY NUMBER
	COUNTY ROAD NUMBER
	CEMETERY
	EXISTING 4" WATER MAIN
	EXISTING 3" WATER MAIN
	EXISTING 2" WATER MAIN
	PROPOSED 2" WATER MAIN
	PROPOSED 2" SERVICE LINE
	PROPOSED 4" WATER MAIN
	PROPOSED 3" WATER MAIN
	2-WAY FIRE HYDRANT
	GATE VALVE
	MASTER METER
	BLOWOFF VALVE
	AIR RELEASE VALVE
	PRESSURE REDUCING VALVE

- GENERAL NOTES:
1. MOUNT SHERMAN WATER ASSOCIATION TO OBTAIN EASEMENTS WHERE WATER LINES CROSS PRIVATE PROPERTY.
 2. CONTRACTOR TO VERIFY THE LOCATIONS OF EXISTING UTILITIES BEFORE PROCEEDING WITH CONSTRUCTION.
 3. WATER MAINS SHALL HAVE A MINIMUM COVER OF 36 INCHES.
 4. WHERE WATER MAINS CROSS EXISTING SEWER MAINS, MINIMUM VERTICAL SEPARATION BETWEEN MAINS WILL BE 18 INCHES.
 5. ALL WATER MAINS MUST BE HORIZONTALLY SEPARATED FROM ANY EXISTING SEWER MAINS BY A MINIMUM OF TEN (10) FEET.

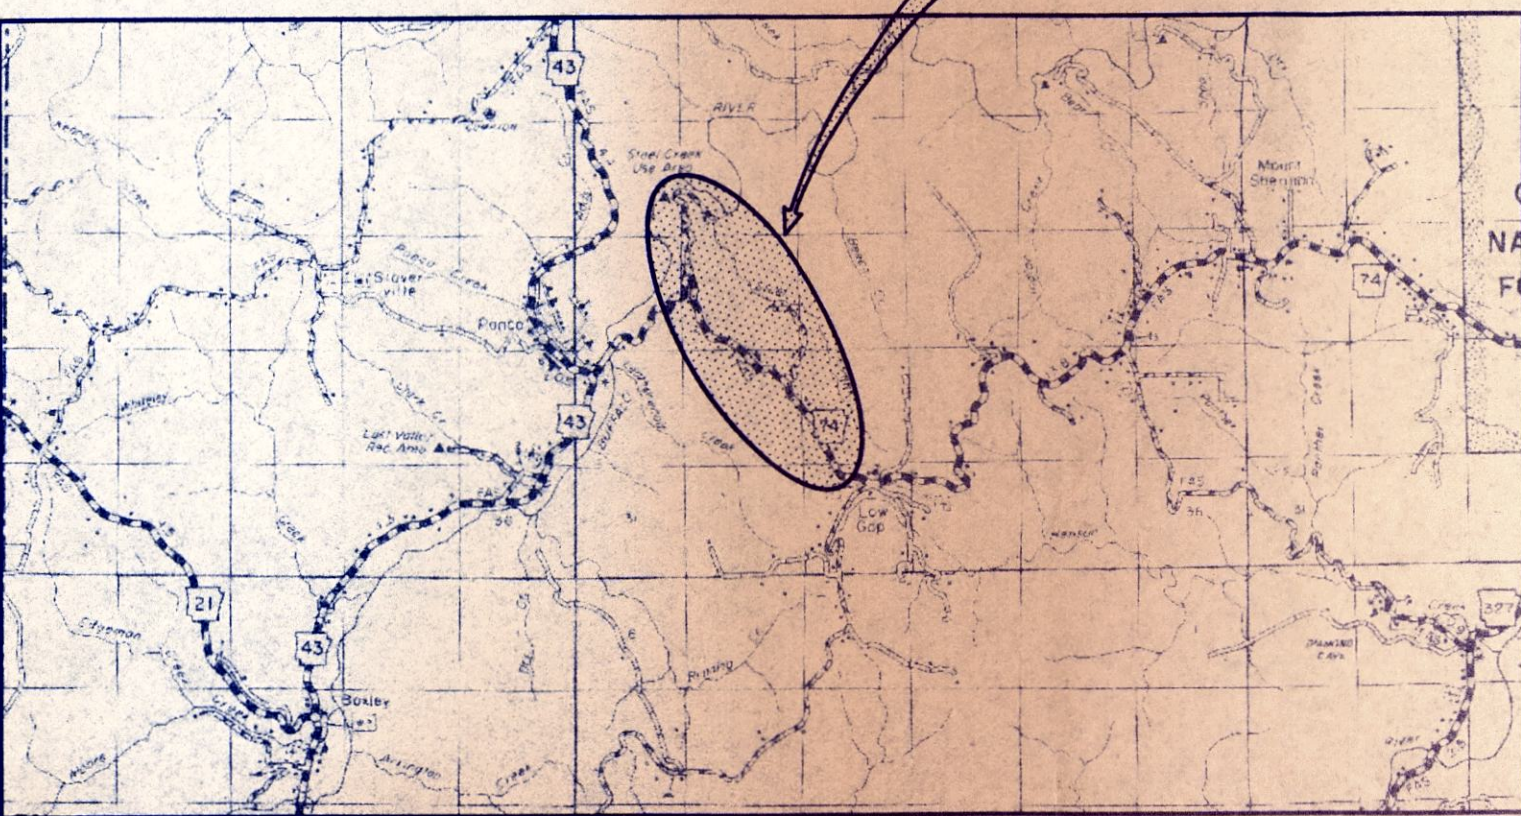

LOCATION MAP AS BUILT
REVISED 11-00

DATE:	DESCRIPTION:
REVISION:	
SCALE:	
DATE:	
ENGINEER:	
DRAWN BY:	
W.O. #	