



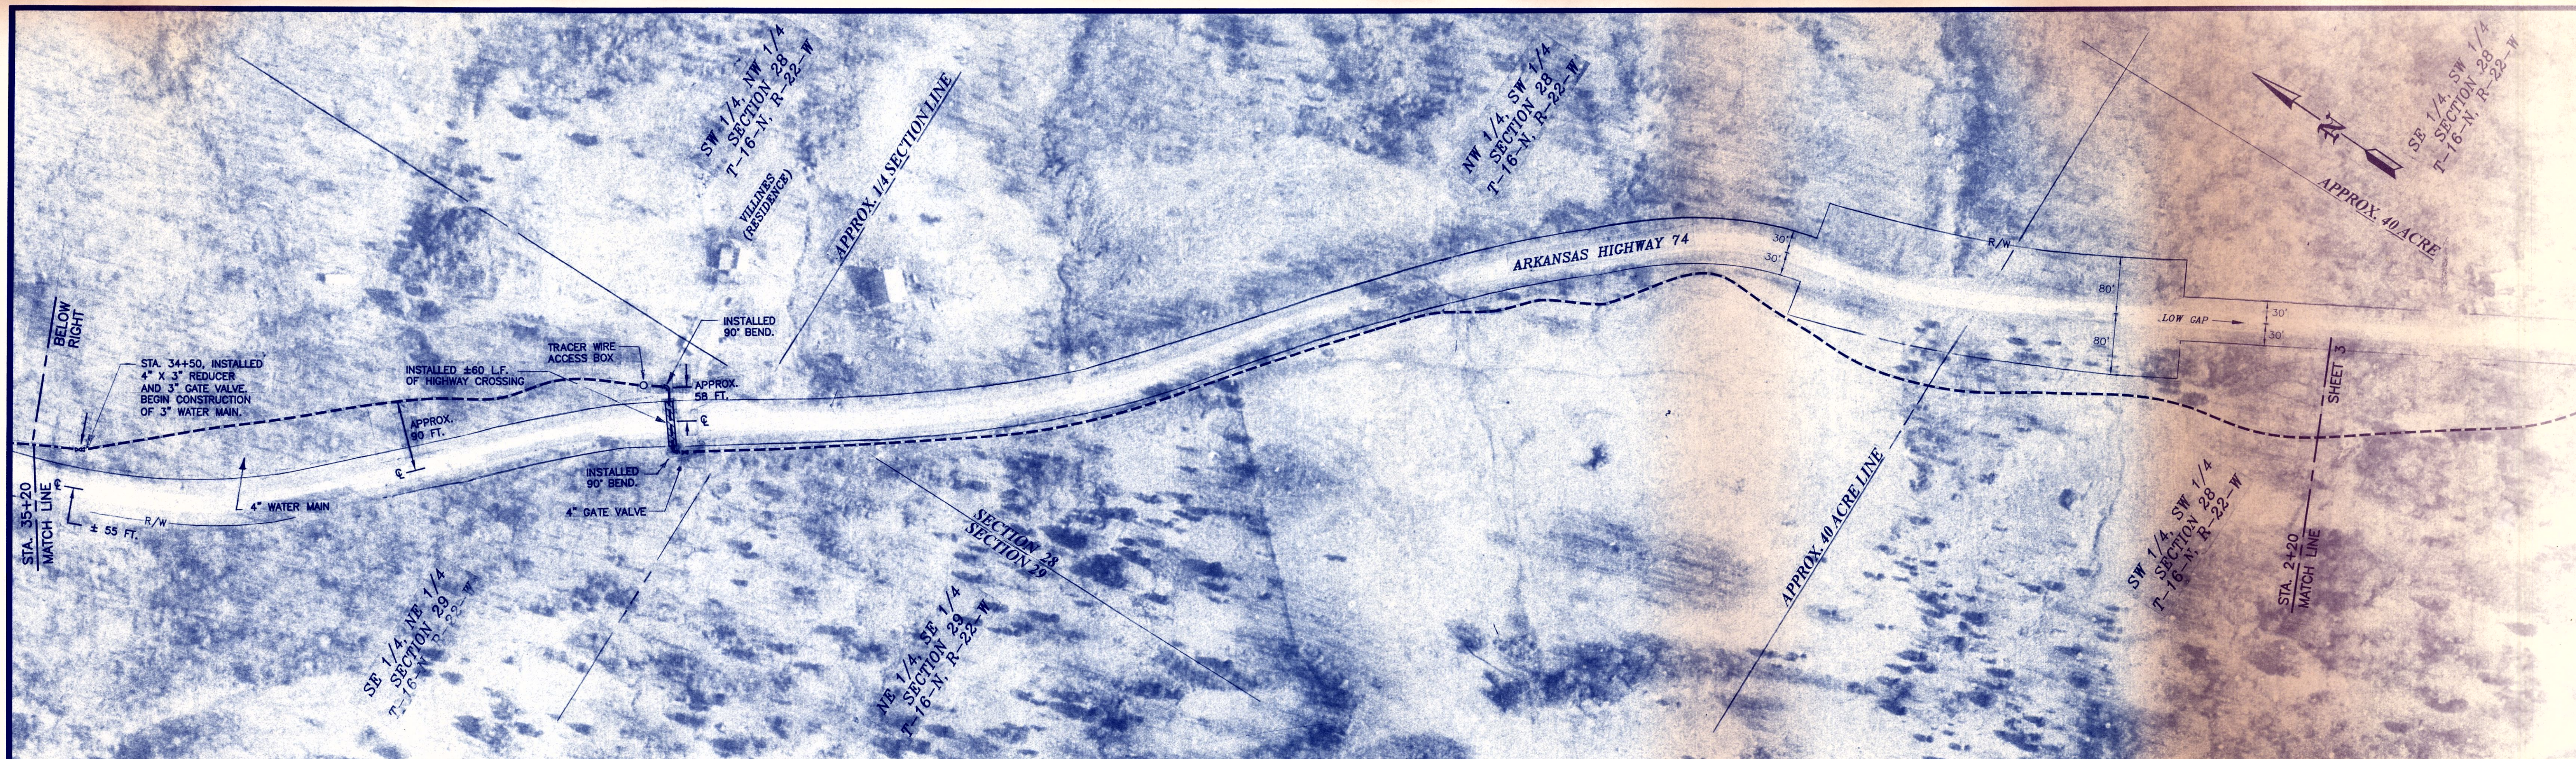

THIS VIEW CLASS 200 PVC PIPE

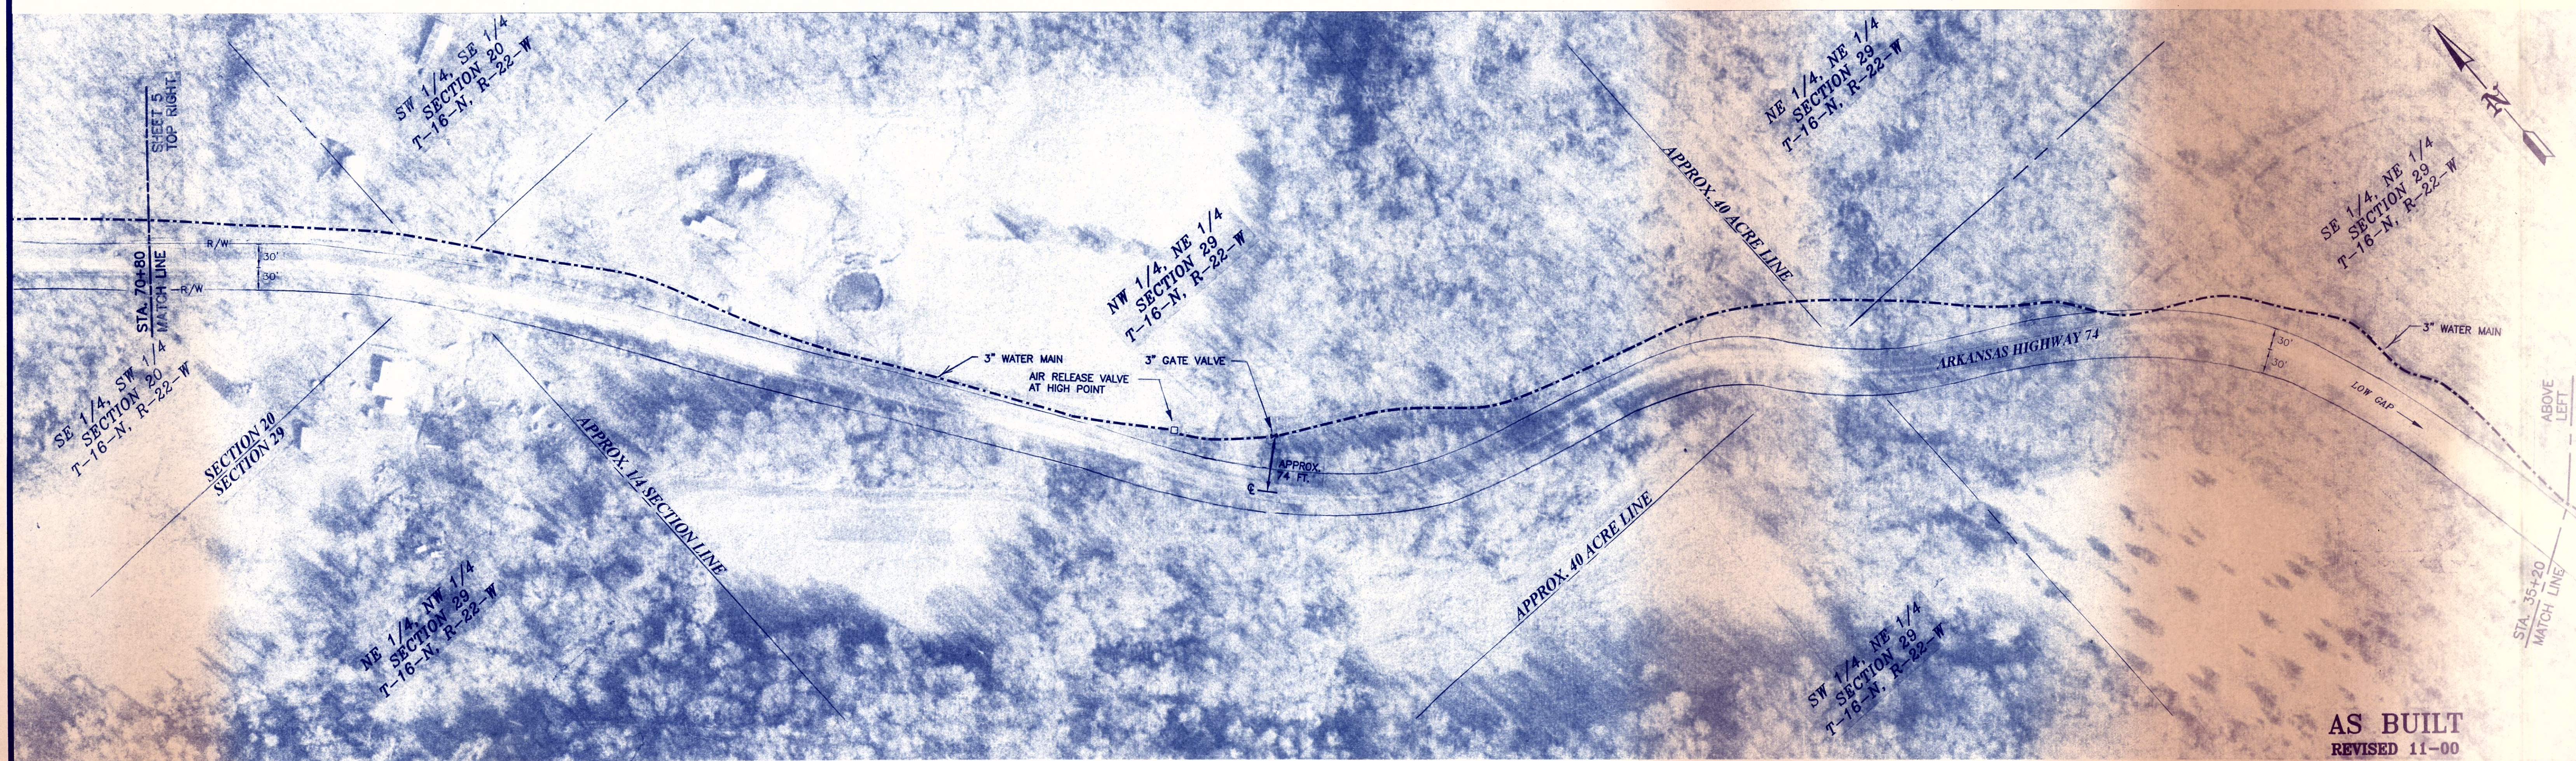

AS BUILT
REVISED 11-00
THIS VIEW CLASS 200 PVC PIPE

- GENERAL NOTES:
- (1) All water mains to have a minimum cover of 30 inches over the top of the pipe.
 - (2) The owner will provide easements where transmission mains cross private property.
 - (3) The contractor shall locate all existing utilities before proceeding with construction. Existing utilities typically are not shown on these plans.

- - - - - PROPOSED 2" WATER MAIN
 - - - - - PROPOSED 3" WATER MAIN
 - - - - - PROPOSED 4" WATER MAIN
 - - - - - PROPOSED 6" WATER MAIN
 - - - - - PROPOSED 8" WATER MAIN
 - - - - - PROPOSED 10" WATER MAIN

LEGEND

- - - - - PROPOSED 12" WATER MAIN
 - - - - - PROPOSED METER SERVICE

□ PROPOSED AIR RELEASE VALVE
 ○ PROPOSED PRESSURE REDUCING VALVE
 □ PROPOSED GATE VALVE
 □ PROPOSED 3-WAY FIRE HYDRANT
 □ PROPOSED 2-WAY FIRE HYDRANT
 ○ PROPOSED BLOW-OFF

REVISION	DATE	DESCRIPTION

SCALE: 1" = ±100'
 DATE:
 ENGINEER:
 DRAWN BY:
 W.O.# 99829



ENGINEERING SERVICES, INC.
 CONSULTING ENGINEERS AND SURVEYORS
 1207 SOUTH OLD MISSOURI ROAD
 SPRINGDALE, ARKANSAS 72764
 © COPYRIGHT 1994, ENGINEERING SERVICES, INC.

PLAN VIEWS
 WATER MAIN EXTENSION
 STEEL CREEK RECREATIONAL AREA
 NEWTON COUNTY, ARKANSAS