


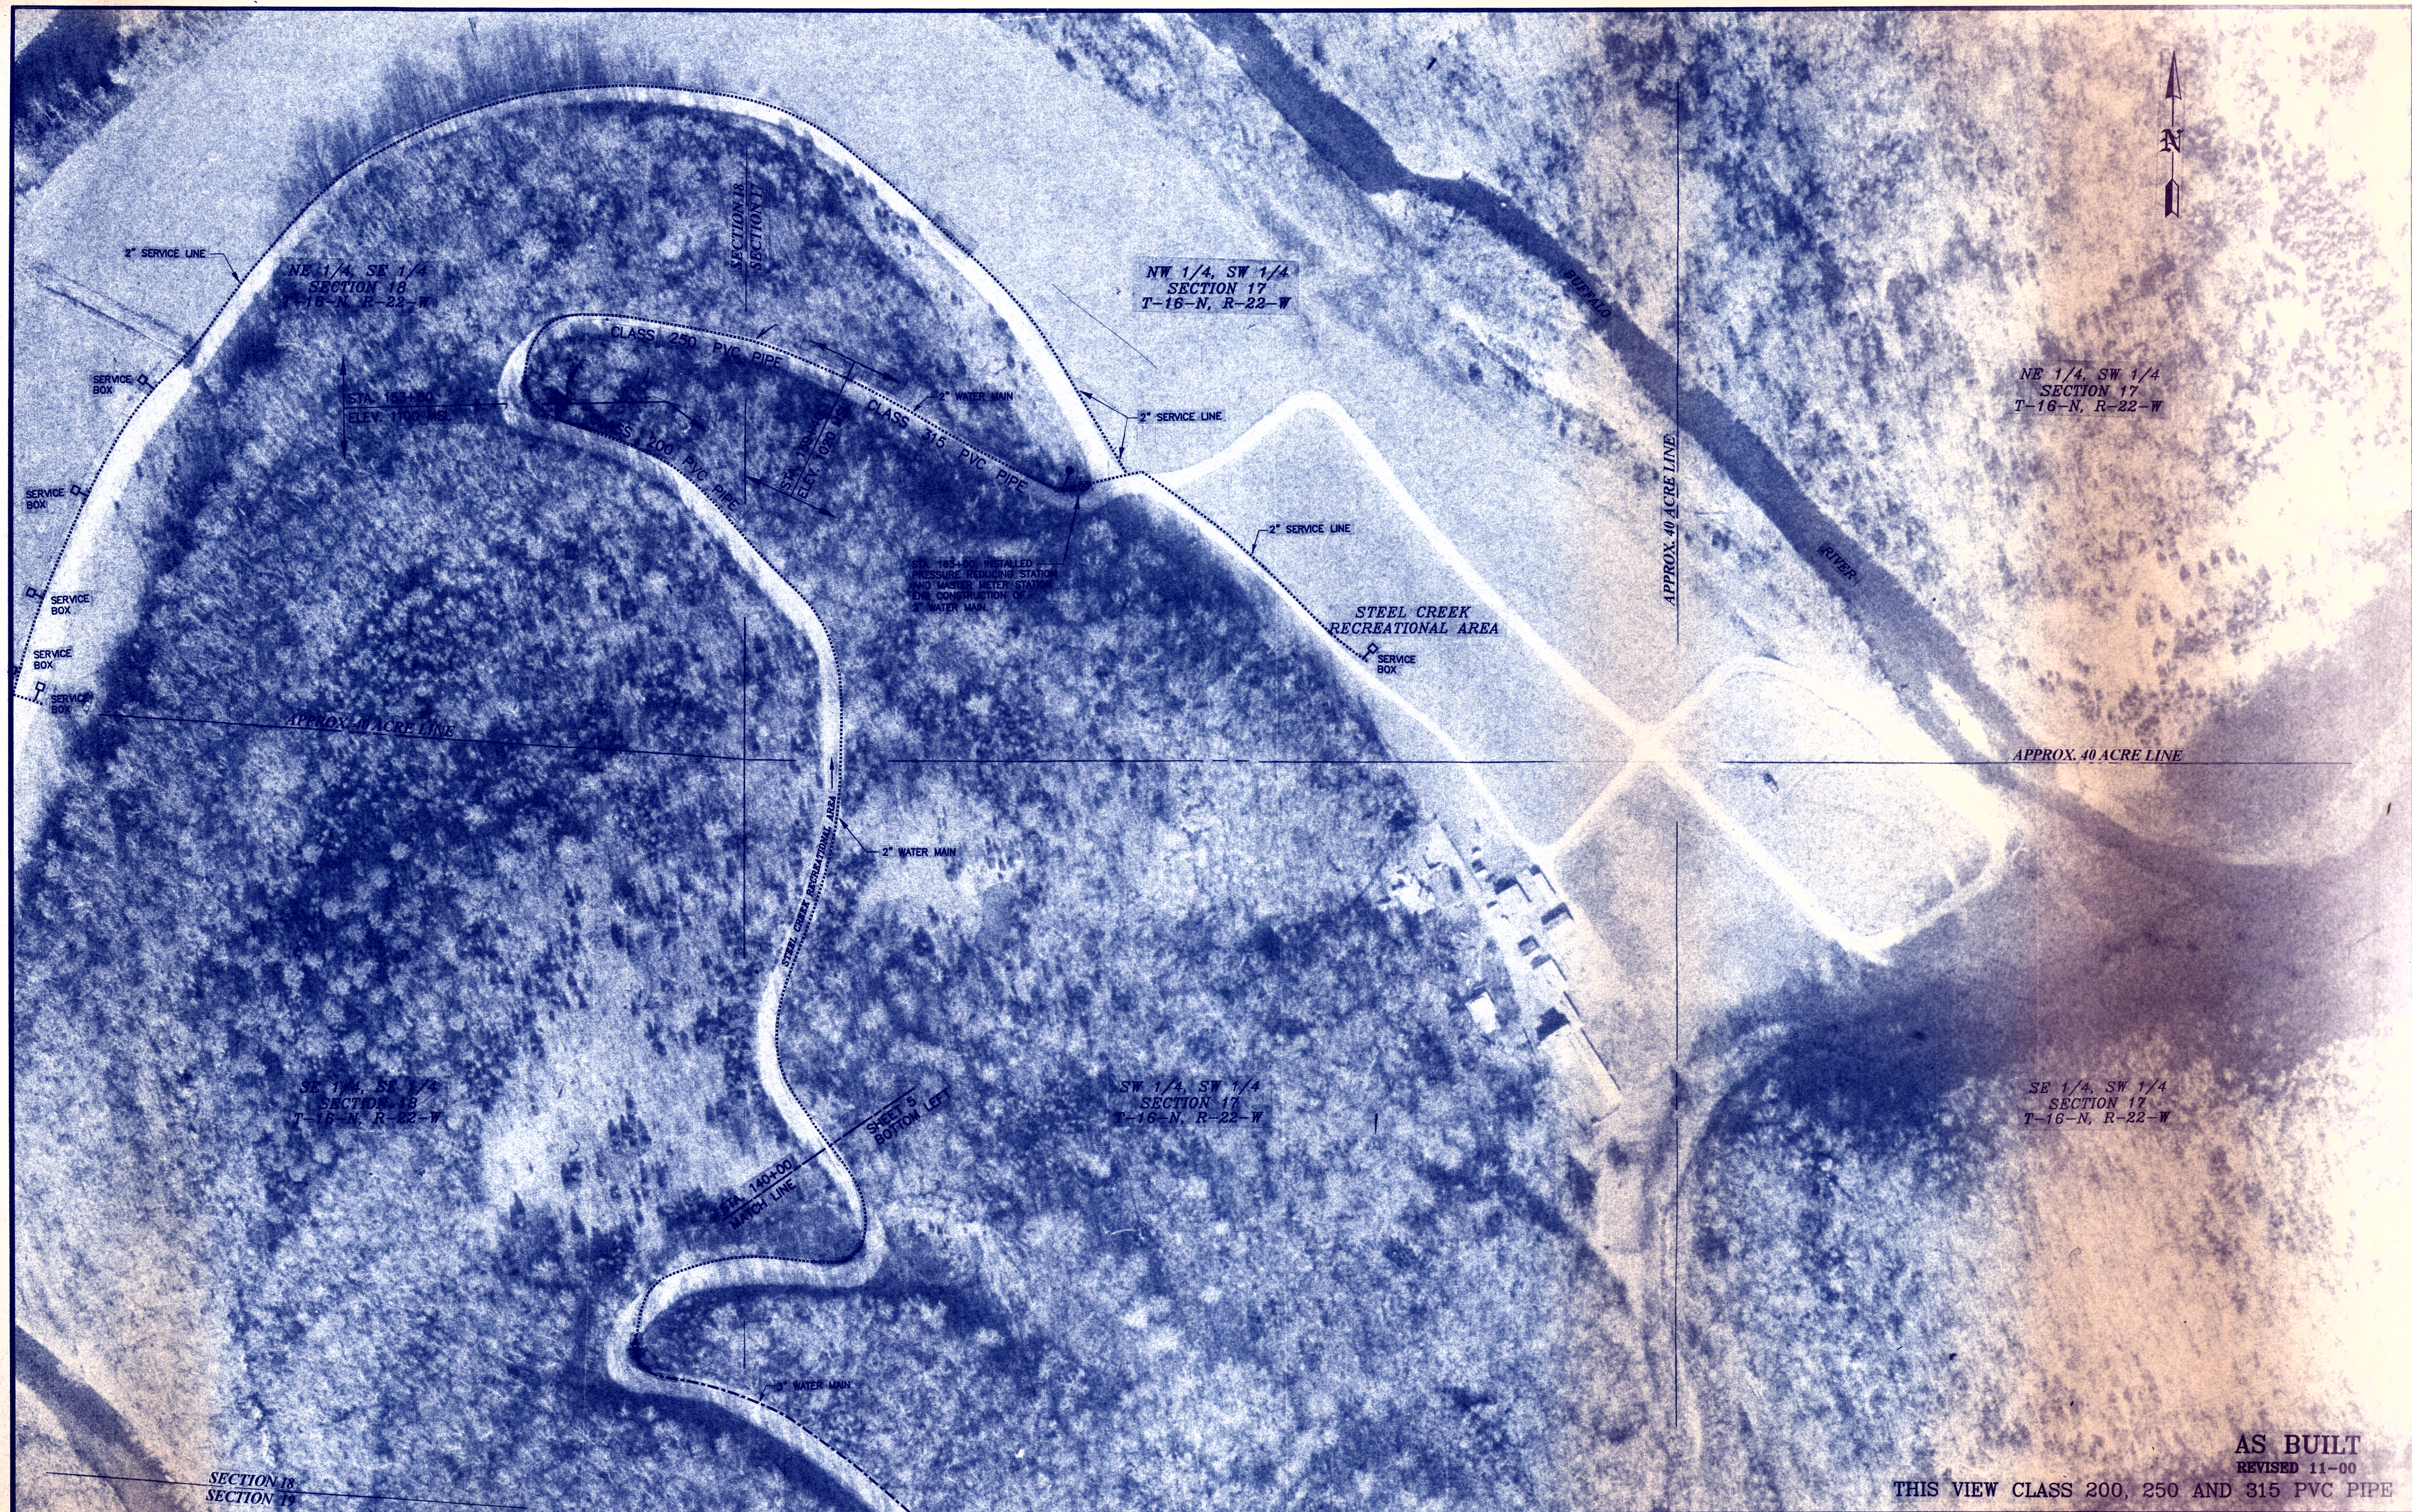

AS BUILT
REVISED 11-00

THIS VIEW CLASS 200, 250 AND 315 PVC PIPE

- GENERAL NOTES:
- (1) All water mains to have a minimum cover of 30 inches over the top of the pipe.
 - (2) The owner will provide easements where transmission mains cross private property.
 - (3) The contractor shall locate all existing utilities before proceeding with construction. Existing utilities typically are not shown on these plans.

PROPOSED 2" WATER MAIN
PROPOSED 3" WATER MAIN
PROPOSED 4" WATER MAIN
PROPOSED 6" WATER MAIN
PROPOSED 8" WATER MAIN
PROPOSED 10" WATER MAIN

LEGEND

PROPOSED 12" WATER MAIN
PROPOSED METER SERVICE

PROPOSED AIR RELEASE VALVE
PROPOSED PRESSURE REDUCING VALVE
PROPOSED GATE VALVE
PROPOSED 3-WAY FIRE HYDRANT
PROPOSED 2-WAY FIRE HYDRANT
PROPOSED BLOW-OFF

REVISION	DATE	DESCRIPTION
1	3-00	ADDED STA. AND ELEV. TO CLASS CHANGES

SCALE: 1" = ±100'
DATE: _____
ENGINEER: _____
DRAWN BY: _____
W.O.# 99829



ENGINEERING SERVICES, INC.
CONSULTING ENGINEERS AND SURVEYORS
1207 SOUTH OLD MISSOURI ROAD
SPRINGDALE, ARKANSAS 72764
© COPYRIGHT, 1998, ENGINEERING SERVICES, INC.

PLAN VIEWS
WATER MAIN EXTENSION
STEEL CREEK RECREATIONAL AREA
NEWTON COUNTY, ARKANSAS