
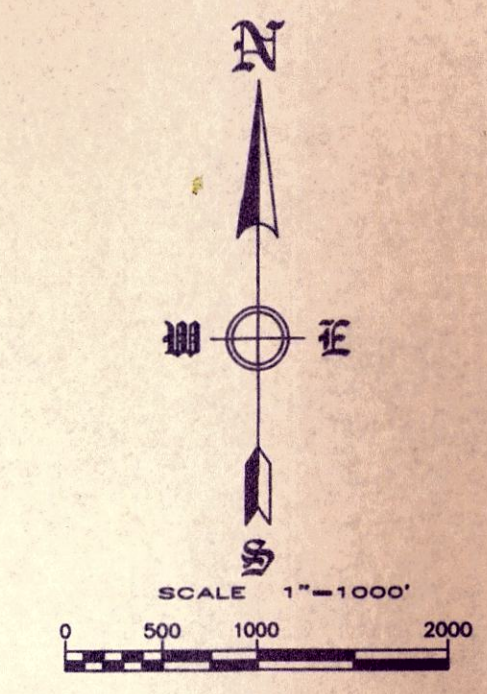


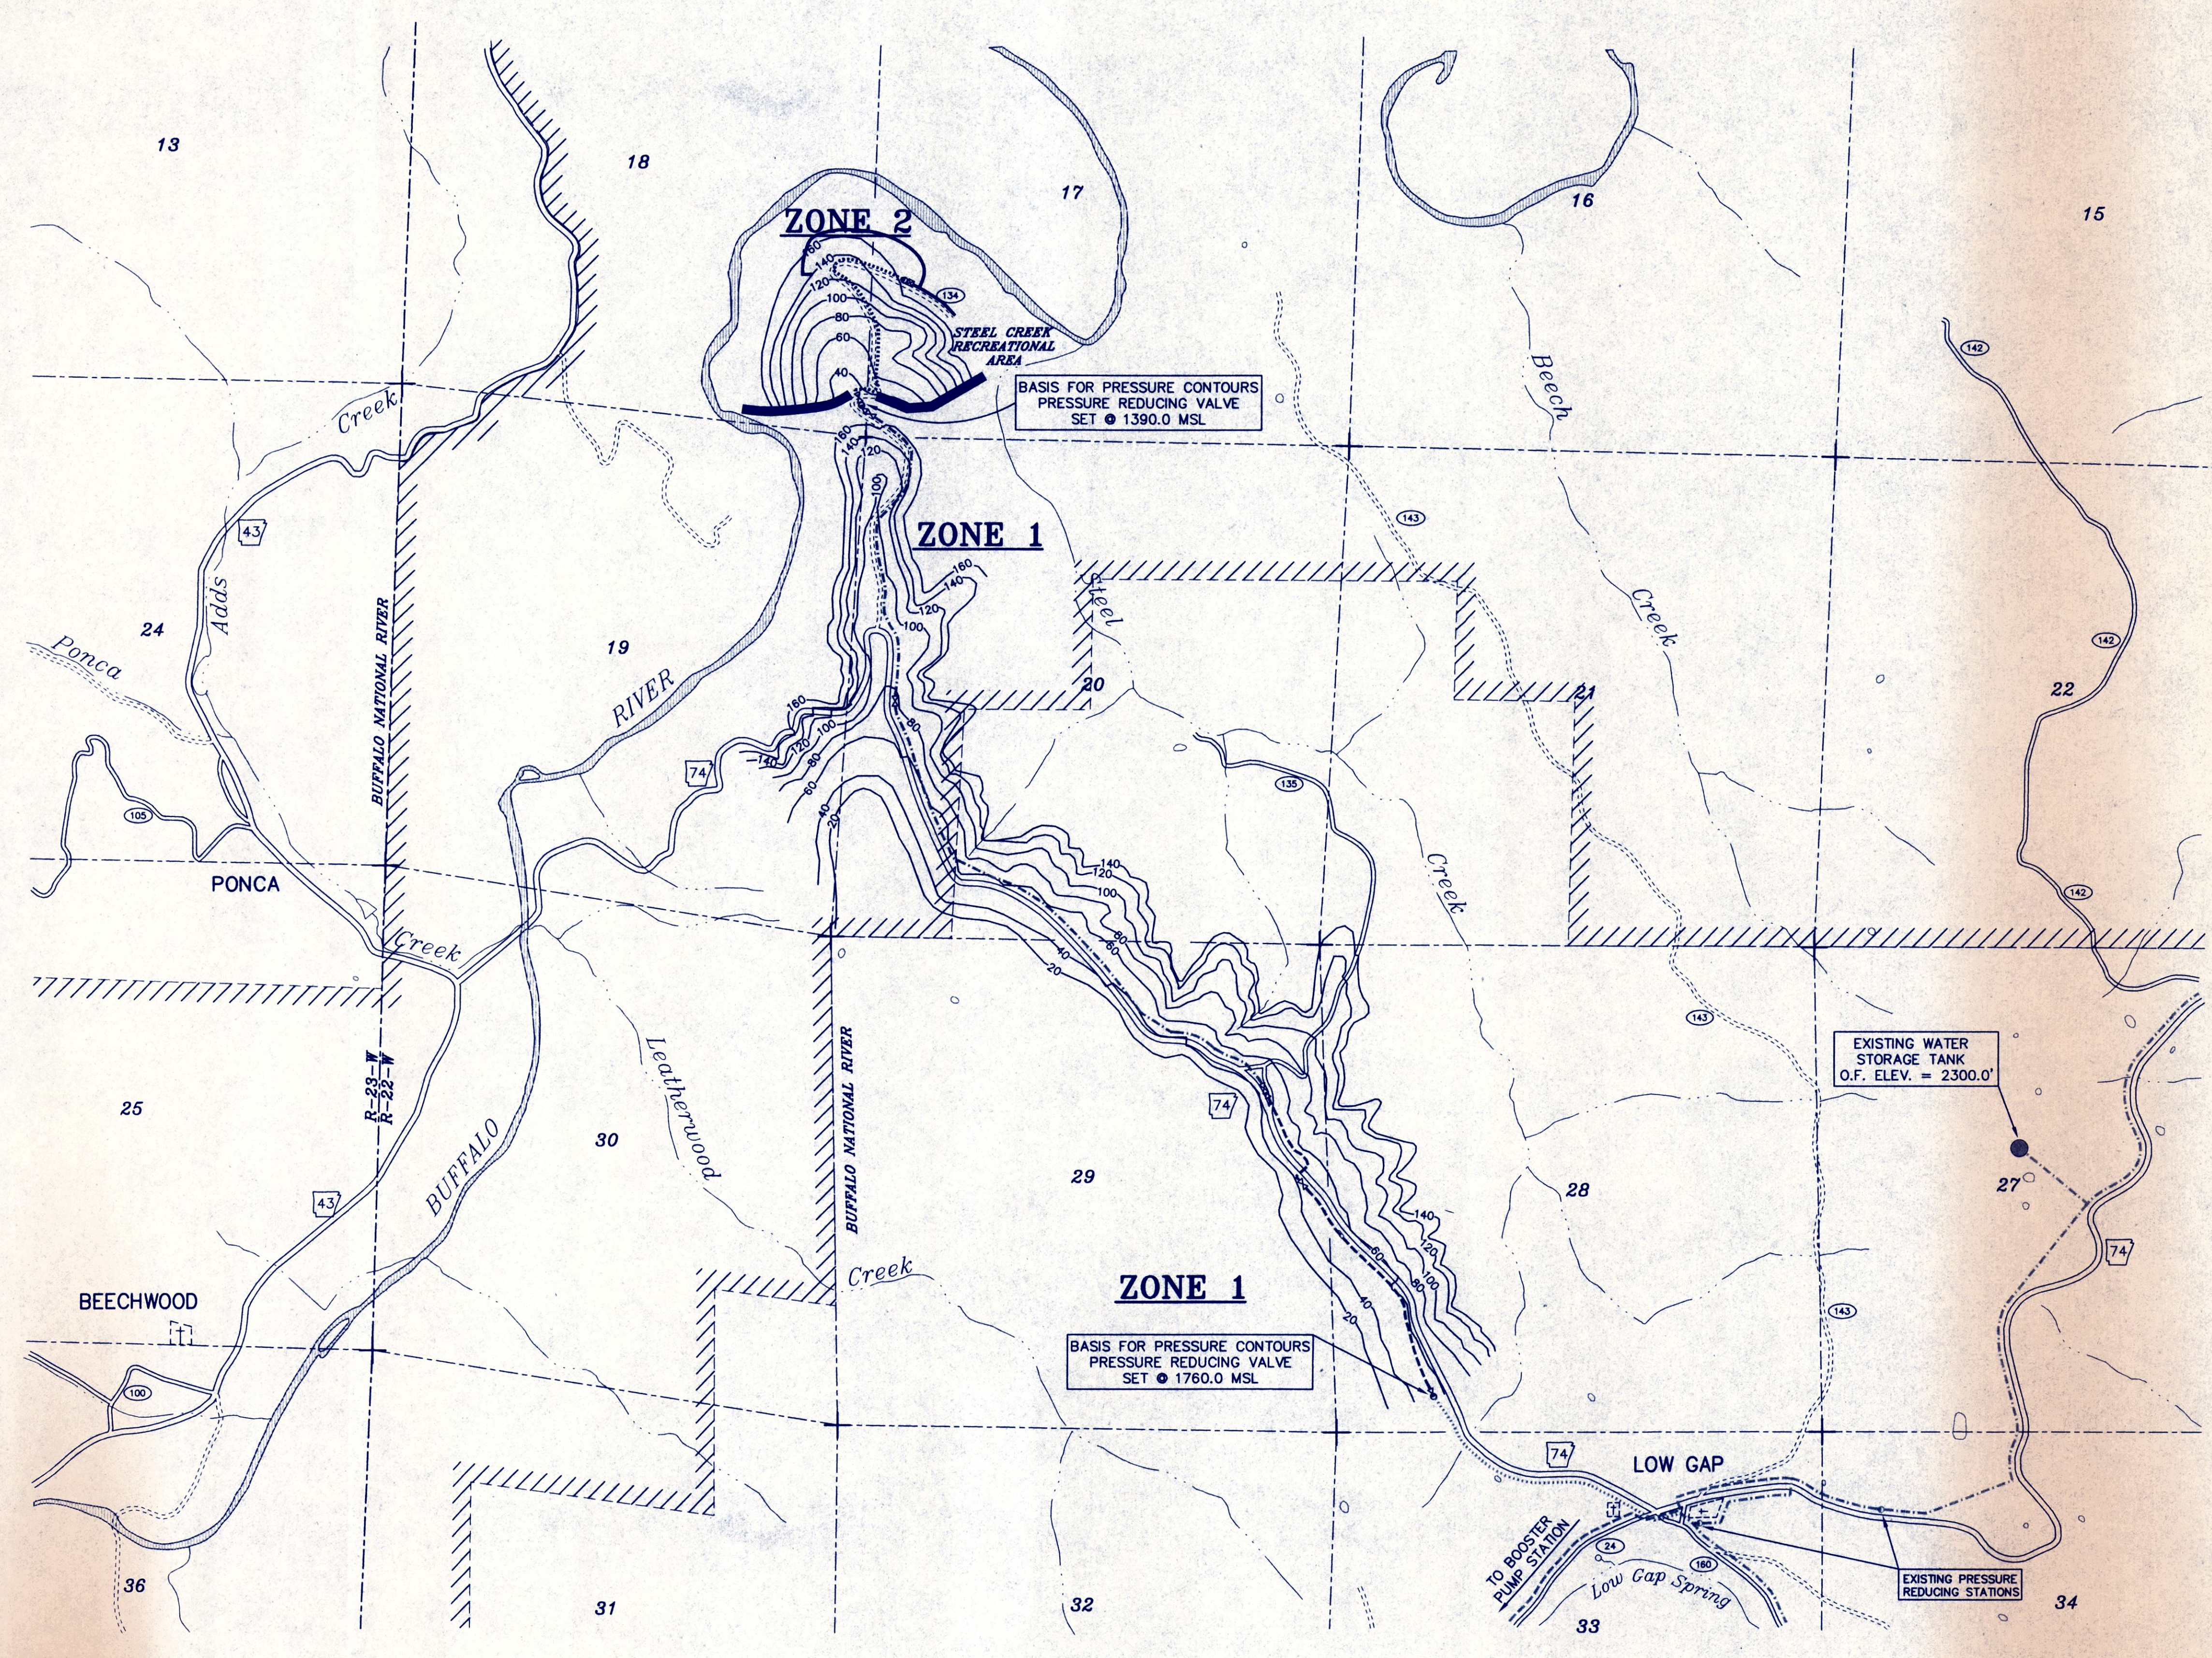

LEGEND	
	STATE HIGHWAY
	PAVED COUNTY ROAD
	GRAVEL COUNTY ROAD
	SECTION AND RANGE LINES
	CREEK
	STATE HIGHWAY NUMBER
	COUNTY ROAD NUMBER
	CEMETERY
	EXISTING 4" WATER MAIN
	EXISTING 3" WATER MAIN
	EXISTING 2" WATER MAIN
	PROPOSED 2" WATER MAIN
	PROPOSED 2" SERVICE LINE
	PROPOSED 4" WATER MAIN
	PROPOSED 3" WATER MAIN
	2-WAY FIRE HYDRANT
	GATE VALVE
	MASTER METER
	BLOWOFF VALVE
	AIR RELEASE VALVE
	PRESSURE REDUCING VALVE
	PRESSURE CONTOURS

BASIS FOR PRESSURE CONTOURS	
ZONE 1	- PRESSURE REDUCING VALVE SET @ 1760.0 MSL
ZONE 2	- PRESSURE REDUCING VALVE SET @ 1390.0 MSL

ENGINEERING SERVICES
INCORPORATED
CONSULTING ENGINEERS AND SURVEYORS
1207 SOUTH OLD MISSOURI RD.
SPRINGDALE, ARKANSAS 72764
© SEPTEMBER 2000, ENGINEERING SERVICES, INC.

PRESSURE CONTOUR MAP
WATER MAIN EXTENSION
STEEL CREEK RECREATIONAL AREA
NEWTON COUNTY, ARKANSAS

REVISION	DATE	DESCRIPTION

SCALE: 1"=1000'
DATE: NOV. 2000
ENGINEER: STP
DRAWN BY:
W.O. #: 99829

AS BUILT
REVISED 11-00

7

\\Server\dw\water\steel_creek\asbu11\99829-steelcreek-pc-asbu1.dwg Thu Nov 09 16:58:59 2000