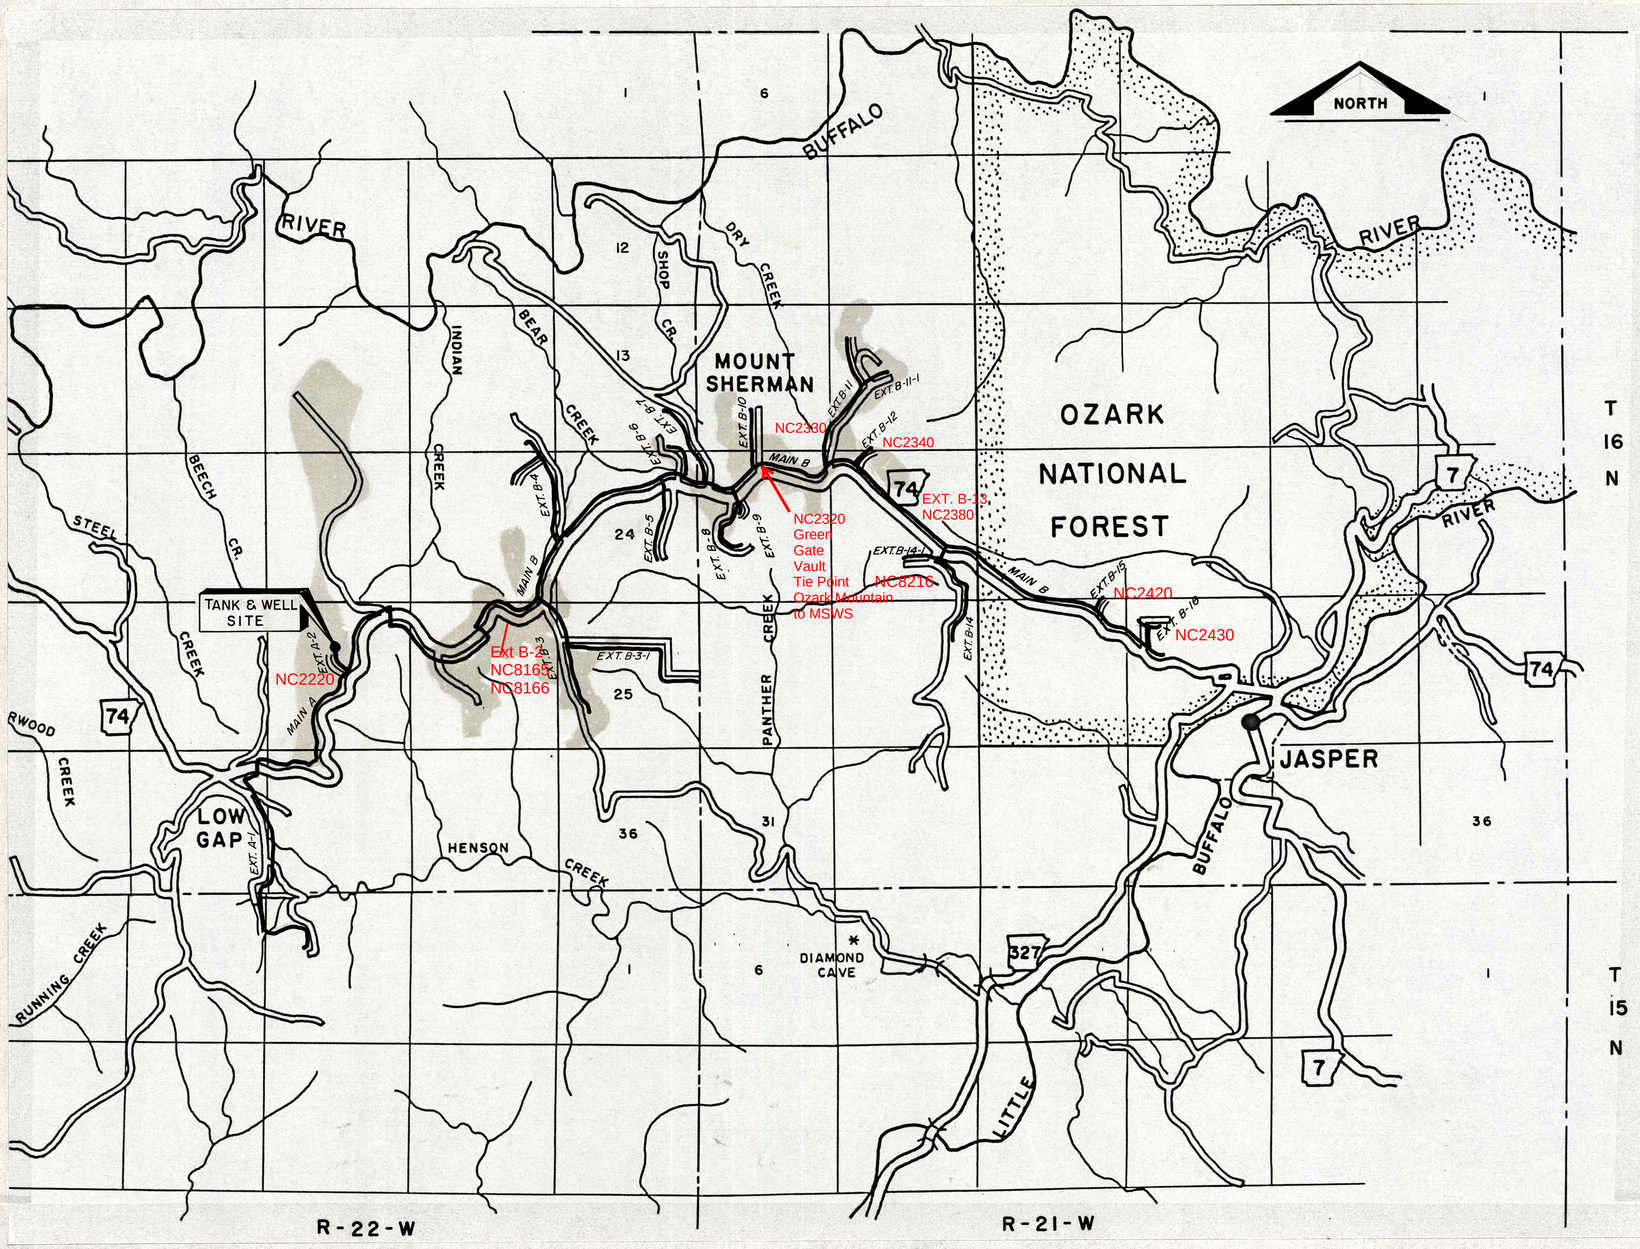

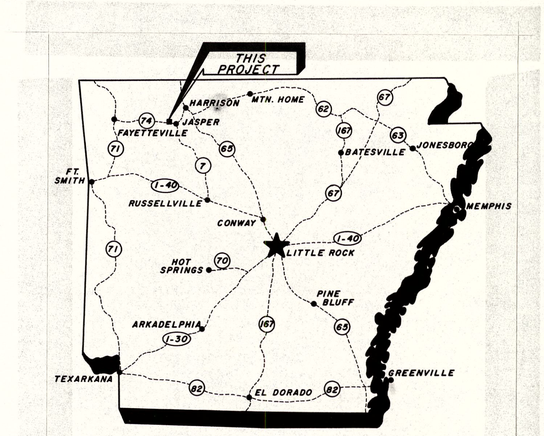

VICINITY MAP

INDEX

TITLE	SHEET
GENERAL LAYOUT ----	1
MAIN A	2
MAIN A & MAIN B	3
MAIN B	4
MAIN B	5
MAIN B	6
MAIN B	7
MAIN B	8
MAIN B	9
EXTENSION A-1	10
EXTENSION A-1-1	11
EXT. A-2, SITE PLAN & PRESSURE REDUCING STATION	12
EXTENSION B-1 & EXTENSION B-2	13
EXTENSION B-3	14
EXTENSION B-3-1	15
EXTENSION B-4	16
EXTENSION B-5	17
EXT. B-6, EXT. B-9 and EXTENSION B-12	18
EXTENSION B-7	19
EXTENSION B-8	20
EXTENSION B-10 & EXTENSION B-16	21
EXTENSION B-11 & EXT. B-11-1	22
EXTENSION B-11 & EXTENSION B-13	23
EXT. B-14-1, EXT. B-14 & EXTENSION B-15	24
WELL HOUSE ARCHITECTURAL DETAILS	25
WELL HOUSE MECHANICAL	26
WELL HOUSE ELECTRICAL	27
STANDPIPE & FOUNDATION DETAILS	28
MISCELLANEOUS DETAILS	29

NOTE: The shaded areas indicate elevations above the 2125' MSL contour. Structures outside the shaded area will experience static pressure above 75 PSI and structure owners are required by the state plumbing code to install individual pressure reducing valves.

RECORD DRAWING
DATE Jan. 9, 1984

DATE	REVISIONS

SURVEY BY:
DESIGN BY: E.T.S.
DRAWN BY:
CHECKED BY: E.T.S.

MT. SHERMAN WATER ASSOCIATION

NEWTON COUNTY ARKANSAS

GENERAL LAYOUT & INDEX

BLAYLOCK, THREET & ASSOCIATES, INC.
Consulting Engineers
MECHANICAL-ELECTRICAL
CIVIL-SURVEYING
1501 MARKET DRIVE
LITTLE ROCK, ARKANSAS

STATE OF ARKANSAS
REGISTERED PROFESSIONAL ENGINEER
RANDALL E. BLAYLOCK 2186
ROBERT M. THREET 2188
JAMES E. PHILLIPS 5202

SCALE: Not to scale

DATE	PROJECT NO.
APL. 1982	80-055-2

SHEET 1 OF 29

BRUNING 40-105-49548