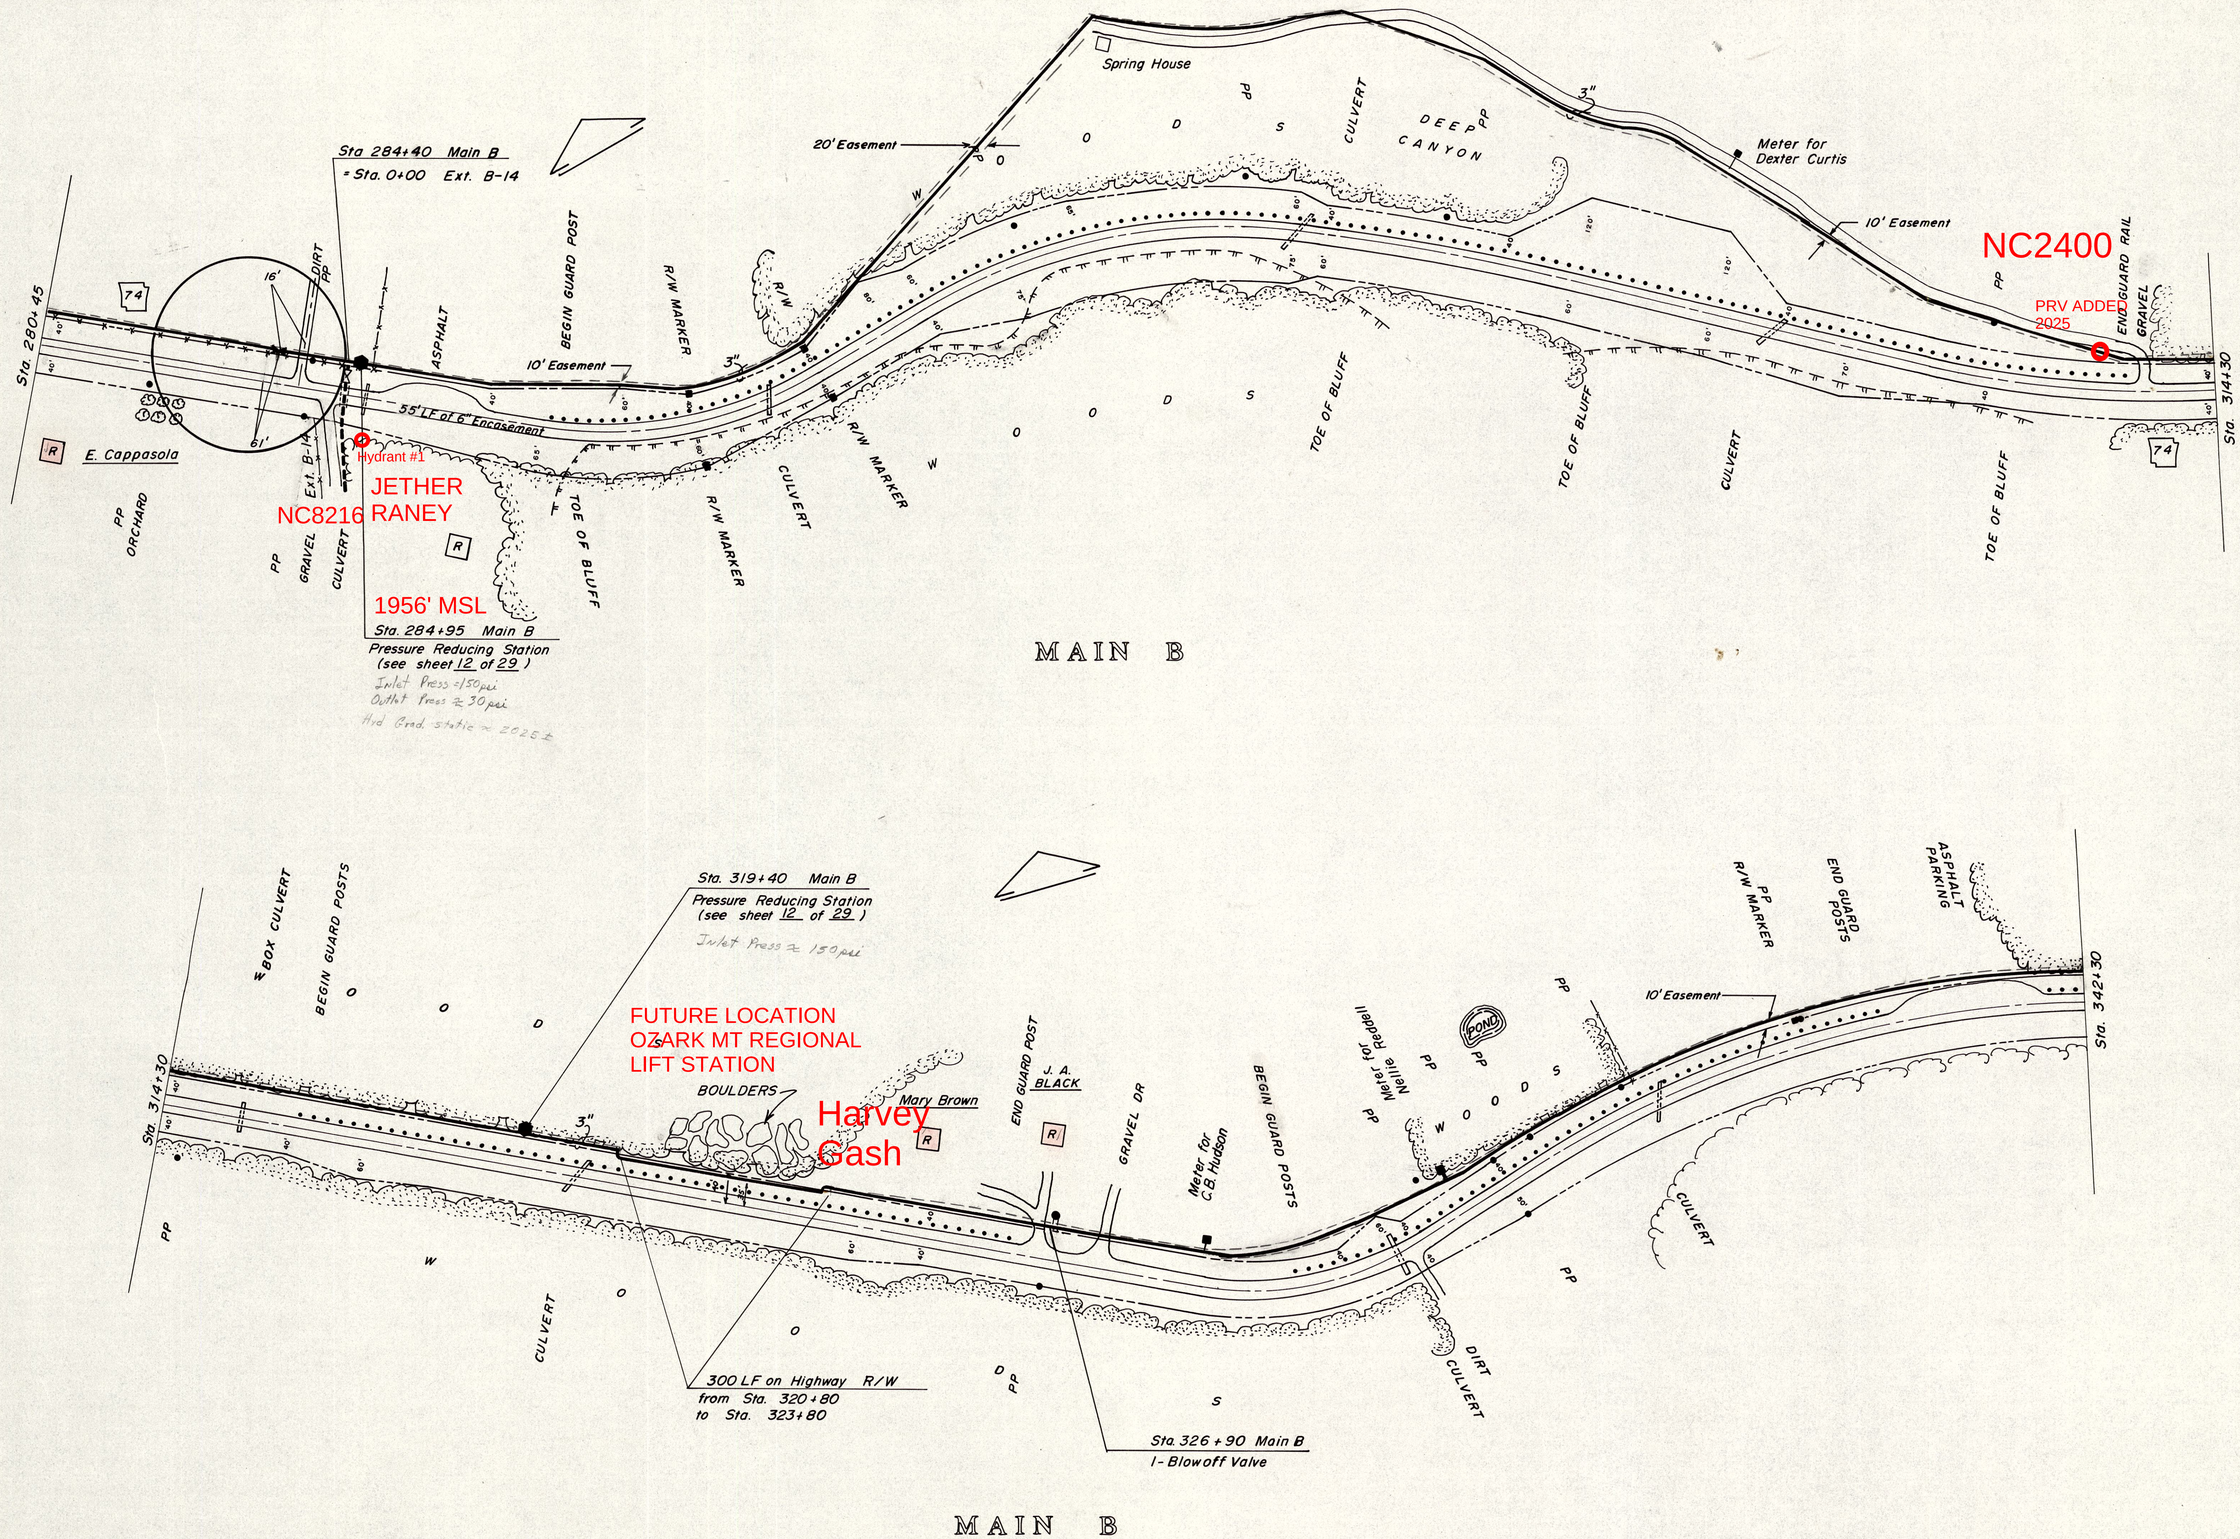

DATE	REVISIONS
11-21-82	Encasement Pipe

SURVEY BY:
DESIGN BY:
DRAWN BY:
CHECKED BY:

MT. SHERMAN WATER ASSOCIATION

NEWTON COUNTY, ARKANSAS

MAIN B

BLAYLOCK, THREET & ASSOCIATES, INC.
Consulting Engineers
MECHANICAL-ELECTRICAL
CIVIL-SURVEYING
1501 MARKET DRIVE
LITTLE ROCK, ARKANSAS

STATE OF ARKANSAS
JAMES R. THREET
REGISTERED PROFESSIONAL ENGINEER
No. 3 3 3 3
REGISTERED PROFESSIONAL ENGINEER

SCALE: 1" = 100'

DATE	PROJECT NO.
APR. 1982	80 055 2

SHEET 8 OF 29

RECORD DRAWING
DATE Jan. 9, 1984

DRAWING: 40-105 495-48