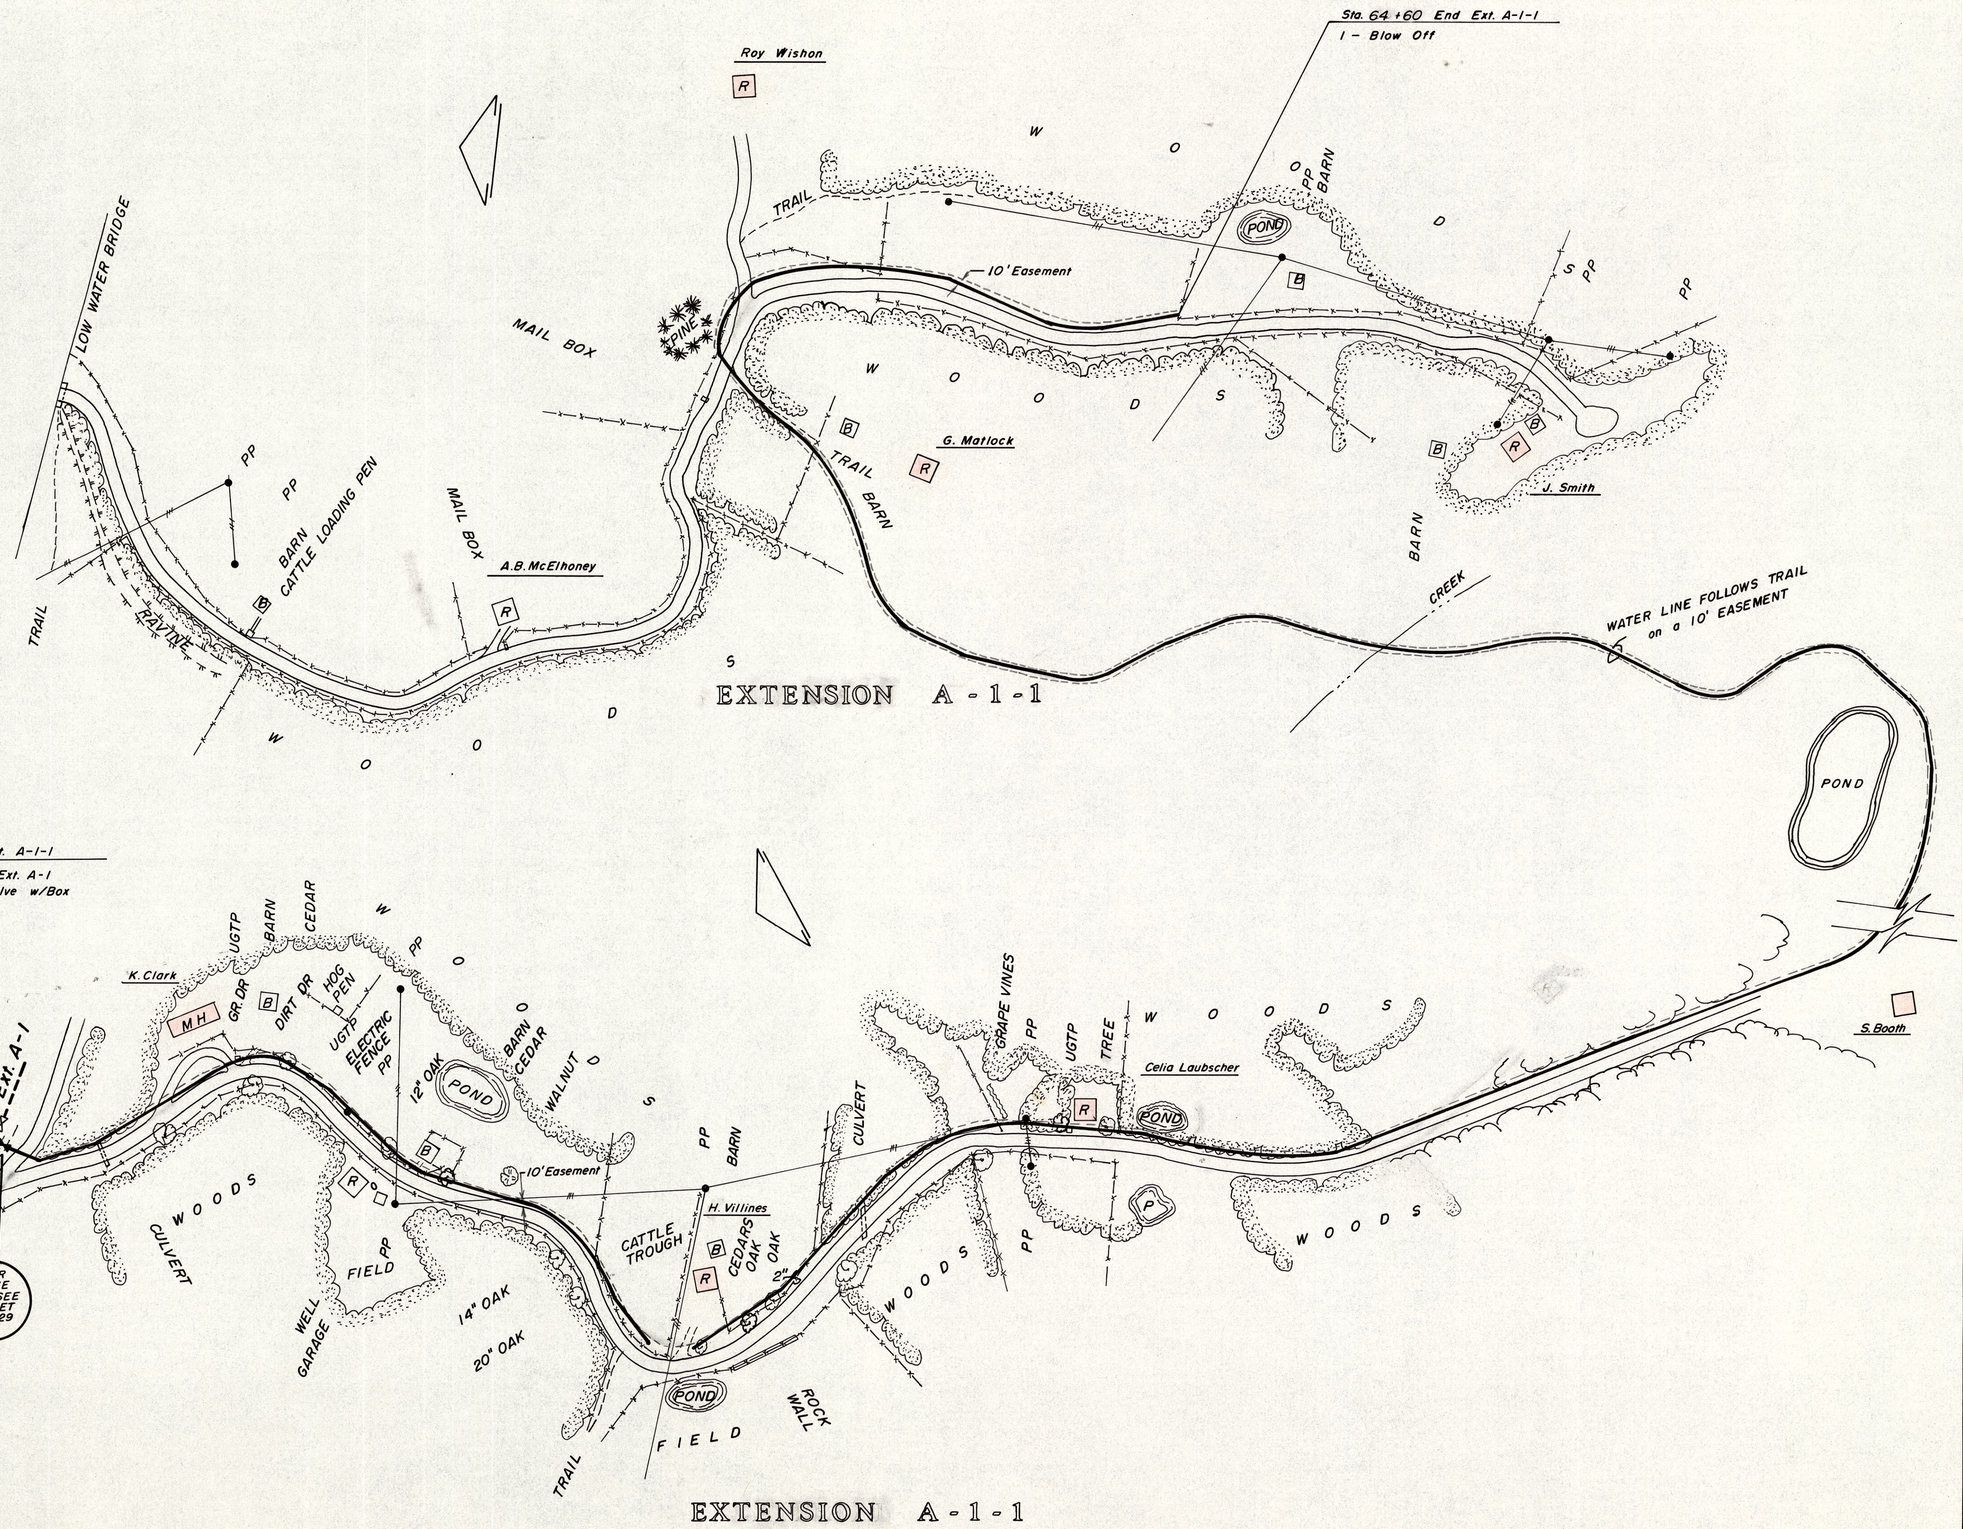

RECORD DRAWING
DATE Jan. 9, 1984

DATE	REVISIONS

SURVEY BY: R.P.
DESIGN BY: E.T.S.
DRAWN BY:
CHECKED BY: E.T.S.

MT. SHERMAN WATER ASSOCIATION

NEWTON COUNTY, ARKANSAS

EXTENSION A-1-1

BLAYLOCK, THREET & ASSOCIATES, INC.
Consulting Engineers
MECHANICAL-ELECTRICAL
CIVIL-SURVEYING
1501 MARKET DRIVE
LITTLE ROCK, ARKANSAS

STATE OF ARKANSAS
REGISTERED PROFESSIONAL ENGINEER
RUSSELL L. BLAYLOCK, ESQ.
ROBERT W. THREET, JR.
JAMES L. PHILLIPS

SCALE 1" = 100'

DATE	PROJECT NO.
APR. 1982	80 055 2

SHEET 11 OF 29

BRUNING 40-105 49548