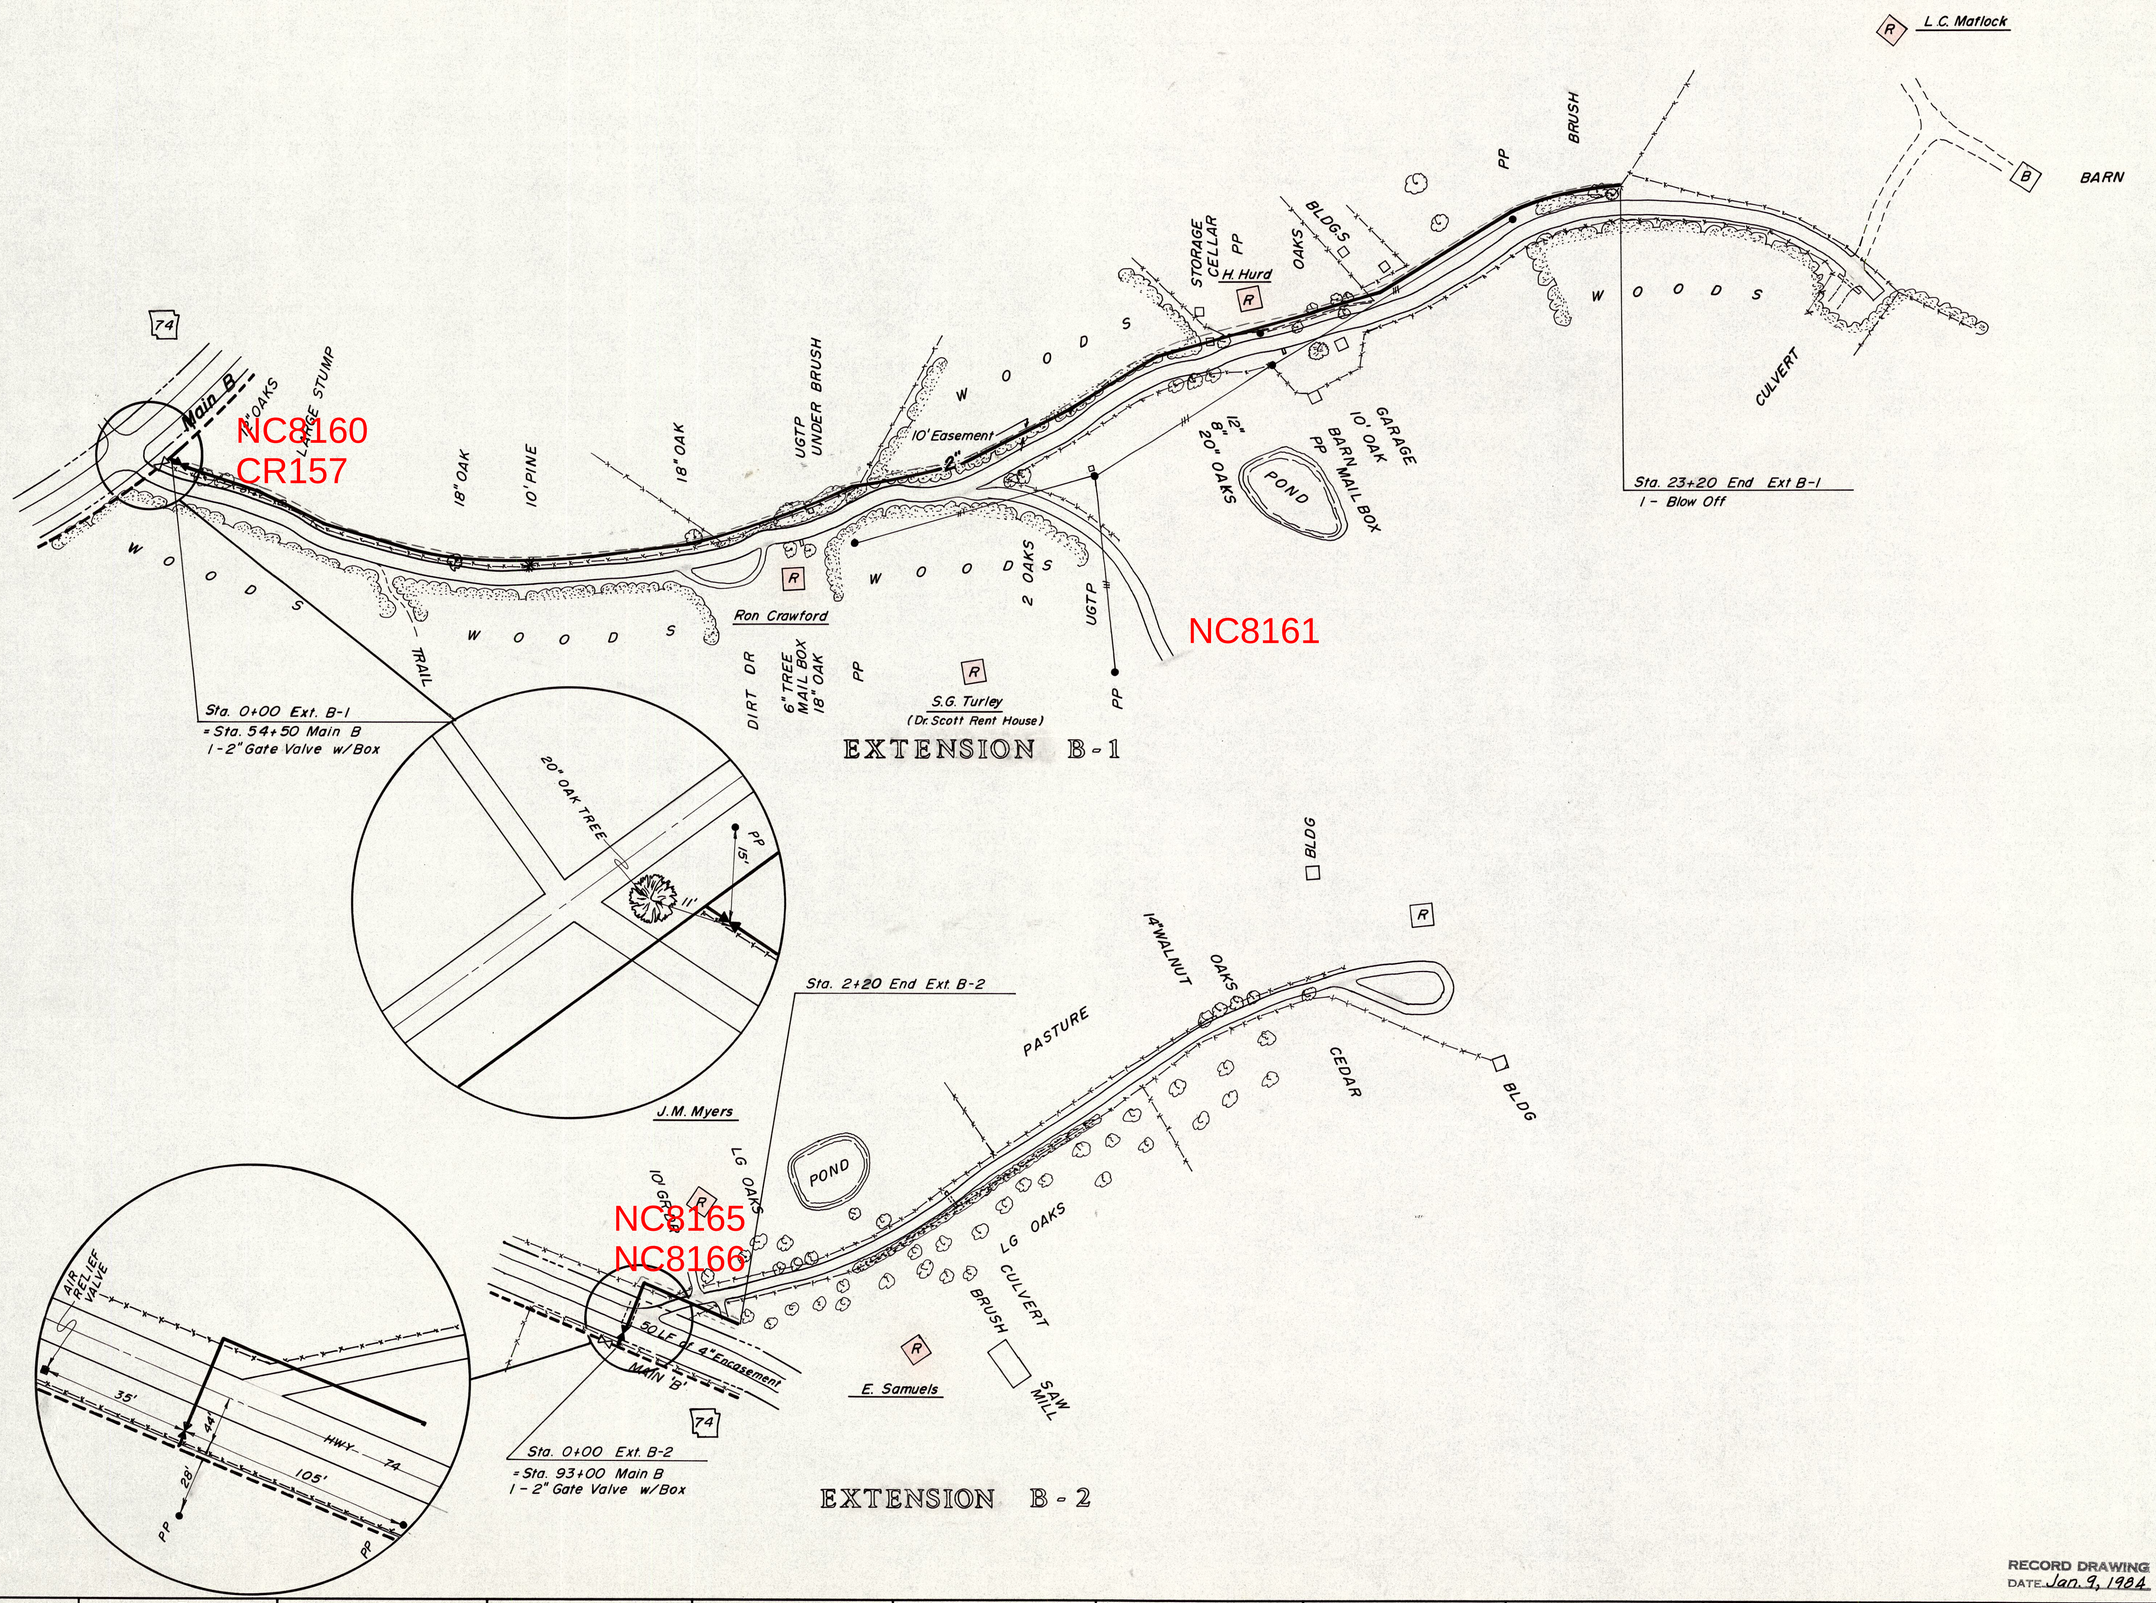

RECORD DRAWING
DATE Jan. 9, 1984

DATE	REVISIONS

SURVEY BY:
DESIGN BY:
DRAWN BY:
CHECKED BY:

MT. SHERMAN WATER ASSOCIATION

NEWTON COUNTY, ARKANSAS

EXTENSION B-1 & EXTENSION B-2

BLAYLOCK, THREET & ASSOCIATES, INC.
Consulting Engineers
MECHANICAL-ELECTRICAL
CIVIL-SURVEYING
1501 MARKET DRIVE
LITTLE ROCK, ARKANSAS

STATE OF ARKANSAS
REGISTERED PROFESSIONAL ENGINEER
ROWLAND C. BLAYLOCK
ROBERT M. THREET
JAMES D. PHILLIPS

SCALE 1" = 100'

DATE	PROJECT NO.
APR. 1982	80055 2

SHEET 13 OF 29

BRUNING 40-105 49548