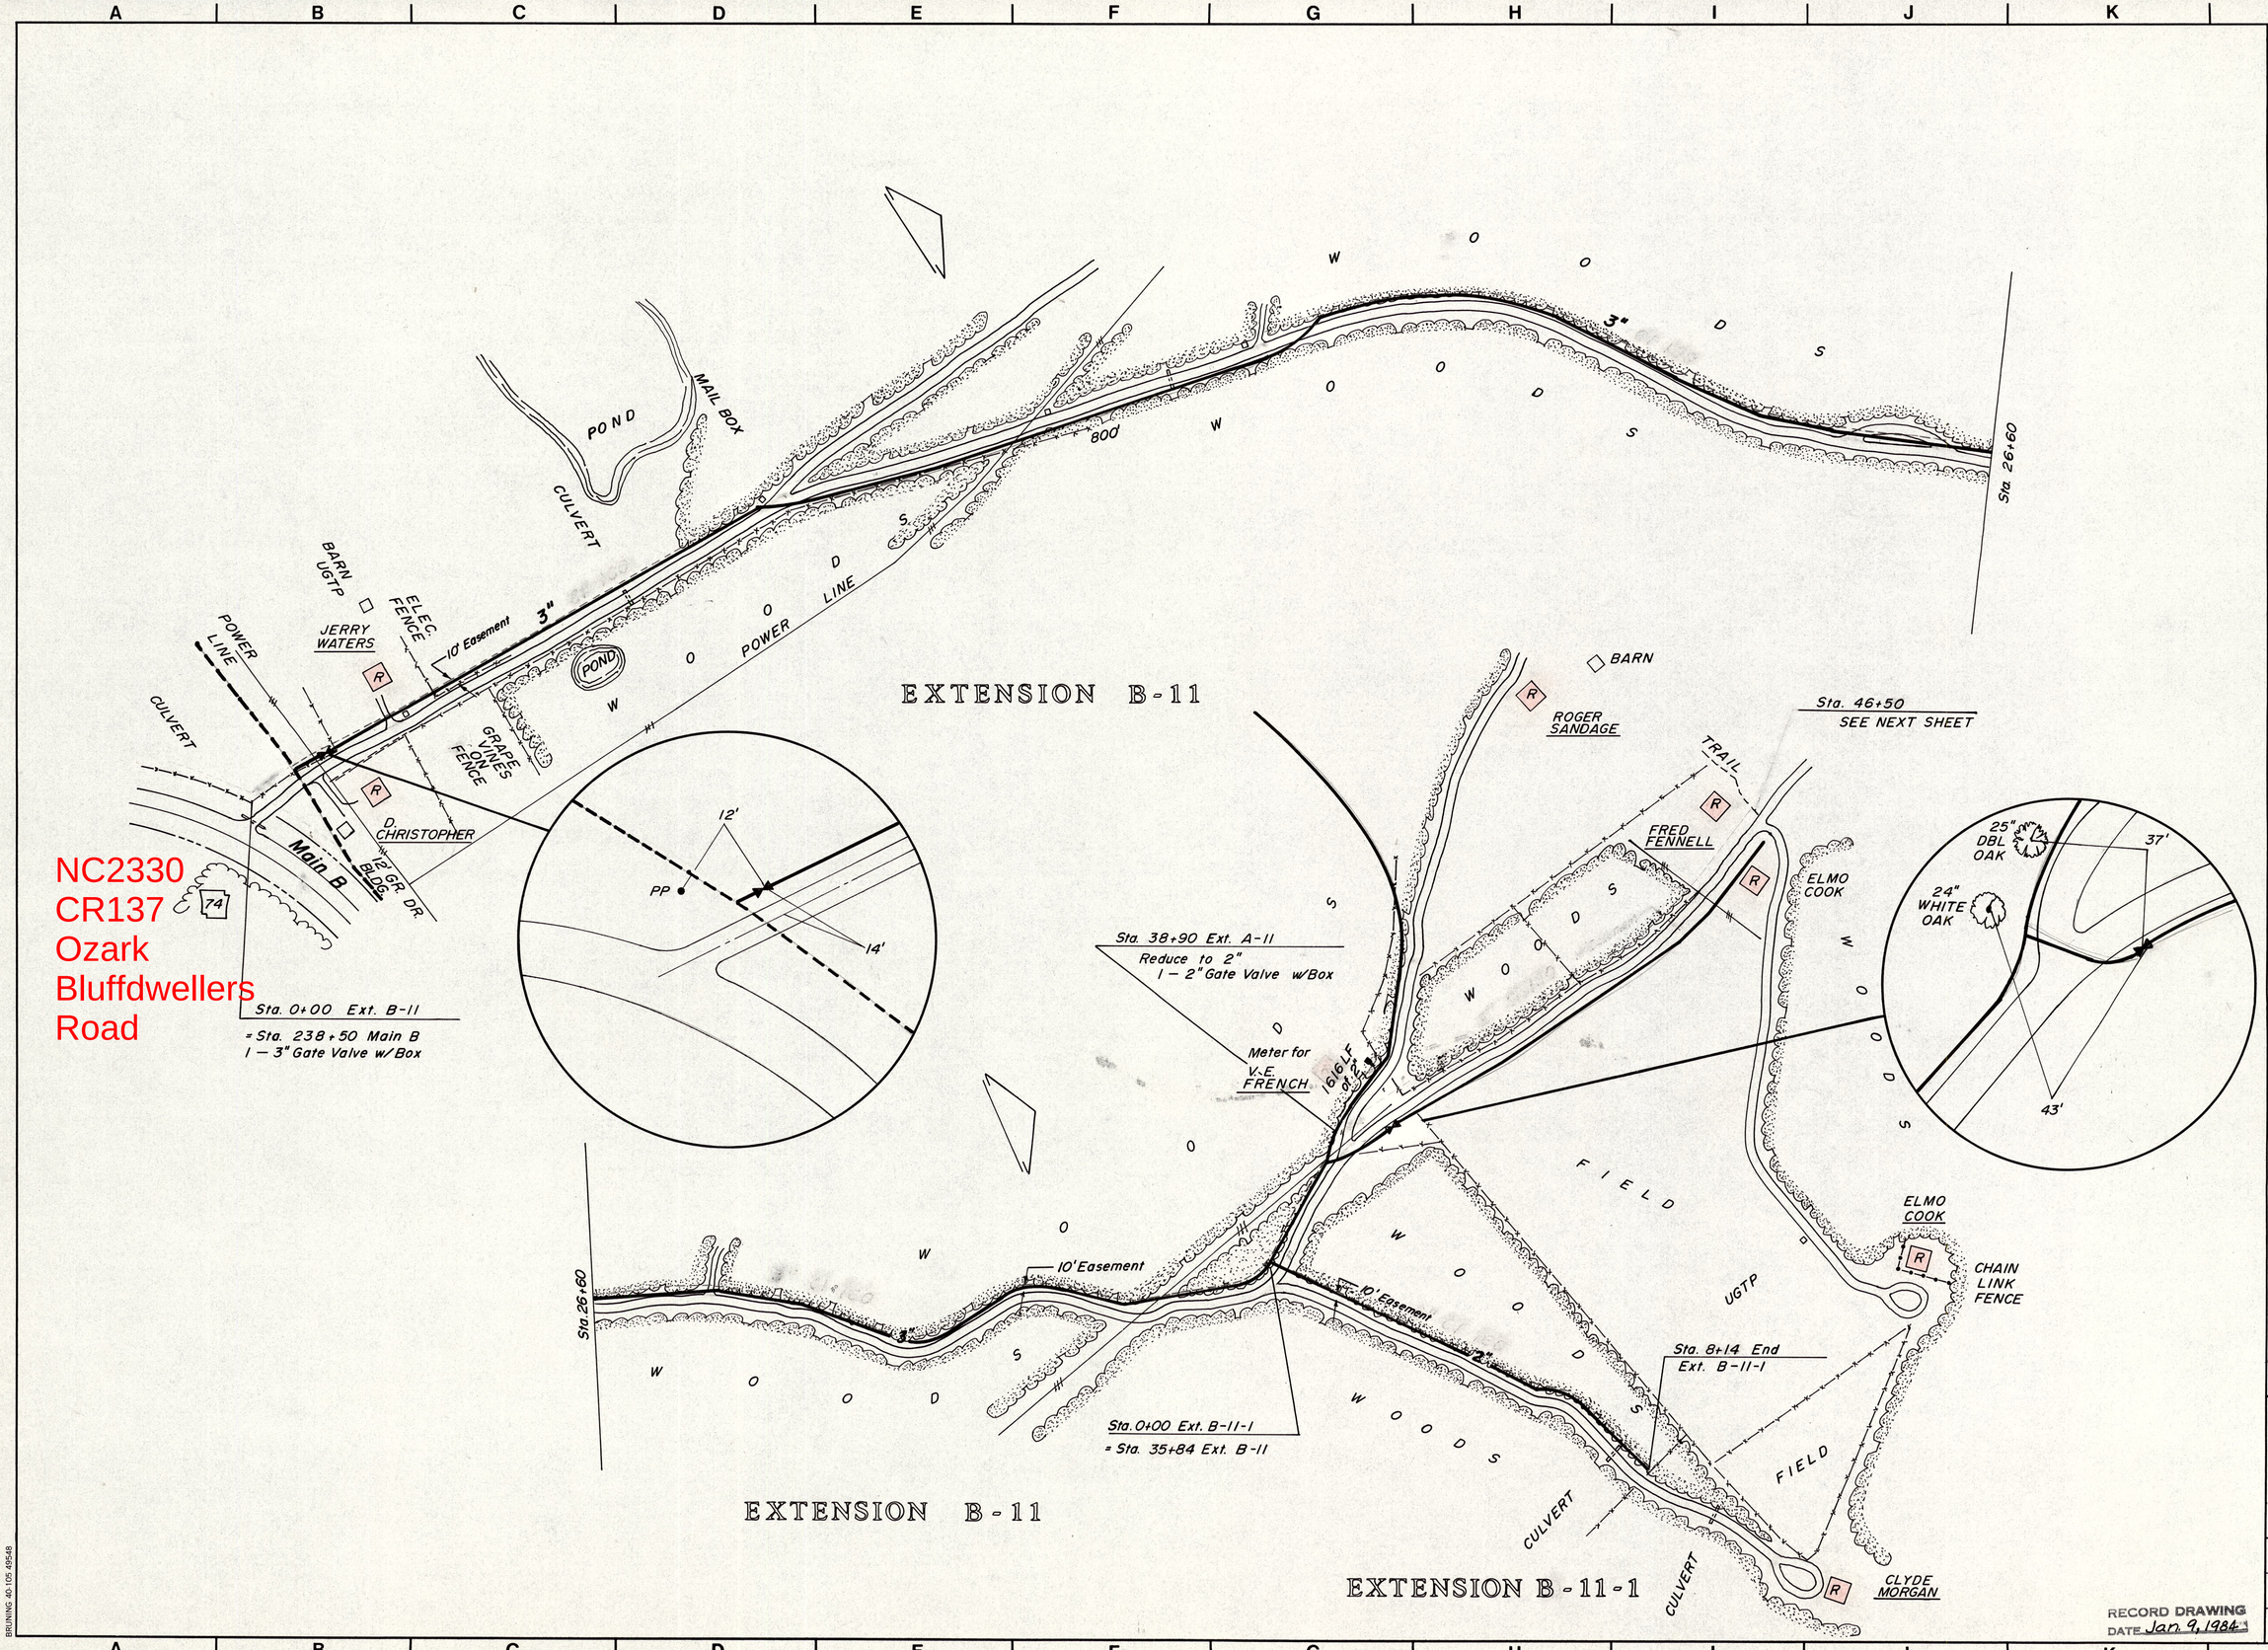

DATE	REVISIONS

SURVEY BY:
DESIGN BY:
DRAWN BY:
CHECKED BY:

MT. SHERMAN WATER ASSOCIATION

ARKANSAS

NEWTON COUNTY,

EXTENSION B-11 & EXTENSION B-11-1

BLAYLOCK, THREET & ASSOCIATES, INC.

Consulting Engineers

MECHANICAL-ELECTRICAL
CIVIL-SURVEYING
1501 MARKET DRIVE
LITTLE ROCK, ARKANSAS

SCALE: 1" = 100'

DATE	PROJECT NO.
APR. 1982	80 055 2

SHEET 22 OF 29

RECORD DRAWING
DATE Jan. 9, 1984

BRUNING 40-105 49548