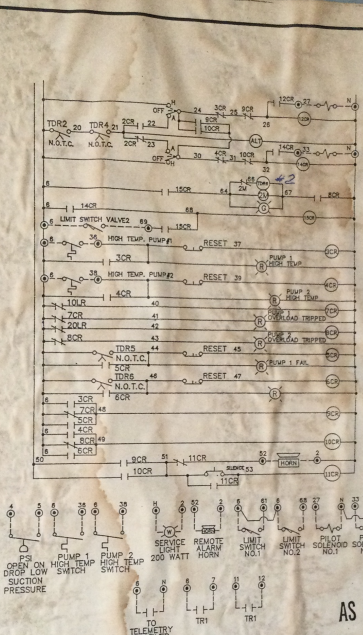

AS BUILT

MORAN
MANUFACTURING INC.
P. O. Box 1264 • Conway, Arkansas 72032
(501) 327-6561

TITLE WATER BOOSTER CONTROLS (2#)
PROJECT MT. SHERMAN
CUSTOMER: I.S.I

JOB. NO. 7500-0004
P.O. NO. 10409
DWG. NO. 75-00041

1:2.5

DATE 5-2-88
REVISED:
REVISED:
REVISED: