EXISTING TANK O.F. ELEV. 2300.00'

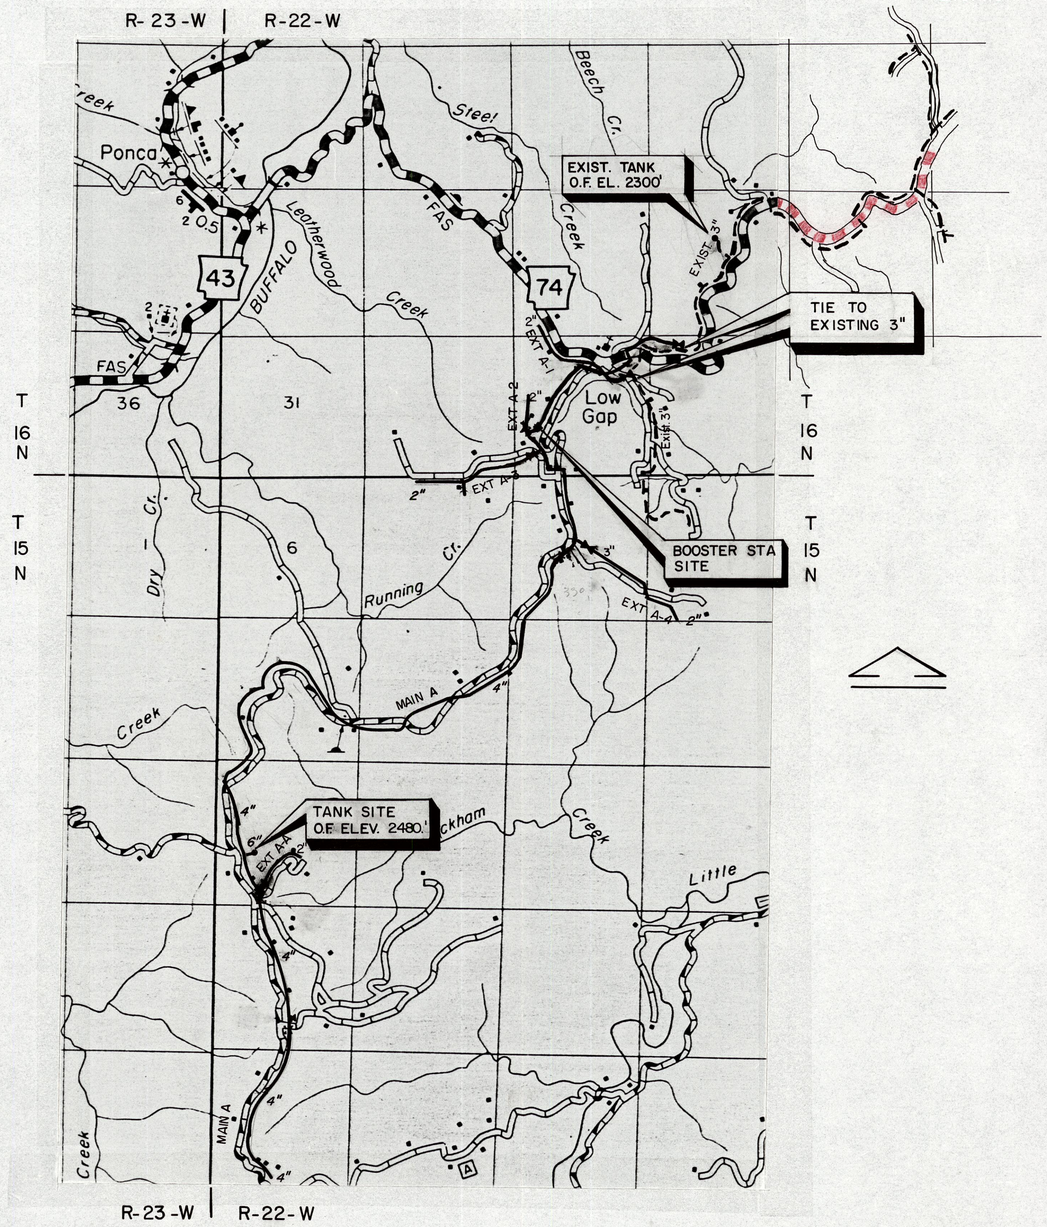

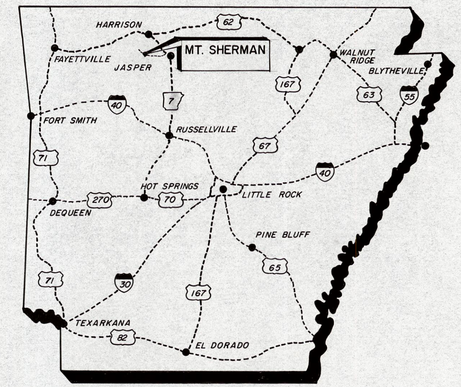

VICINITY MAP

INDEX

SHEET TITLE	PAGE NO.
GENERAL LAYOUT & INDEX	1
CONTOUR MAP	2
MAIN A & EXT A-1	3
MAIN A & EXT A-2	4
MAIN A, EXT A-3 & EXT A-4	5
MAIN A	6
MAIN A	7
MAIN A	8
MAIN A & EXT A-A	9
MAIN A	10
MAIN A	11
MAIN A & EXT A-A	12
EXT A-1	13
EXT A-3	14
EXT A-2	15
EXT A-4	16
STANDPIPE DETAILS & SITE PLAN	17
BOOSTER STATION & DETAILS	18
MISCELLANEOUS DETAILS	19

NOTE:
HIGH PRESSURE IS ANTICIPATED ON THIS PROJECT. INDIVIDUALS SHOULD CHECK THEIR SERVICE PRESSURE AND INSTALL PRESSURE REDUCING VALVES WHEN THE PRESSURE EXCEEDS 75 P.S.I. AS REQUIRED BY THE STATE PLUMBING CODE.

RECORD DRAWING
OCT 1988

DATE	REVISIONS

SURVEY BY:
DESIGN BY:
DRAWN BY:
CHECKED BY:

WATER SYSTEM IMPROVEMENT FOR
MT. SHERMAN WATER ASSOCIATION
NEWTON COUNTY ARKANSAS

GENERAL LAYOUT & INDEX

Blaylock Threet Phillips and Associates Inc.
consulting engineers
MECHANICAL - ELECTRICAL
CIVIL - SURVEYING
1501 MARKET DR.
LITTLE ROCK, ARKANSAS 72211
(501) 224-3922

STATE OF ARKANSAS
REGISTERED PROFESSIONAL ENGINEER
RAWLAND E. BLAYLOCK 814
ROBERT W. THREET 2198
JAMES L. PHILLIPS 3028

SCALE
1" = 1/2 Mile

DATE	PROJECT NO.
JULY 1987	87 040 2

SHEET 1 OF 19