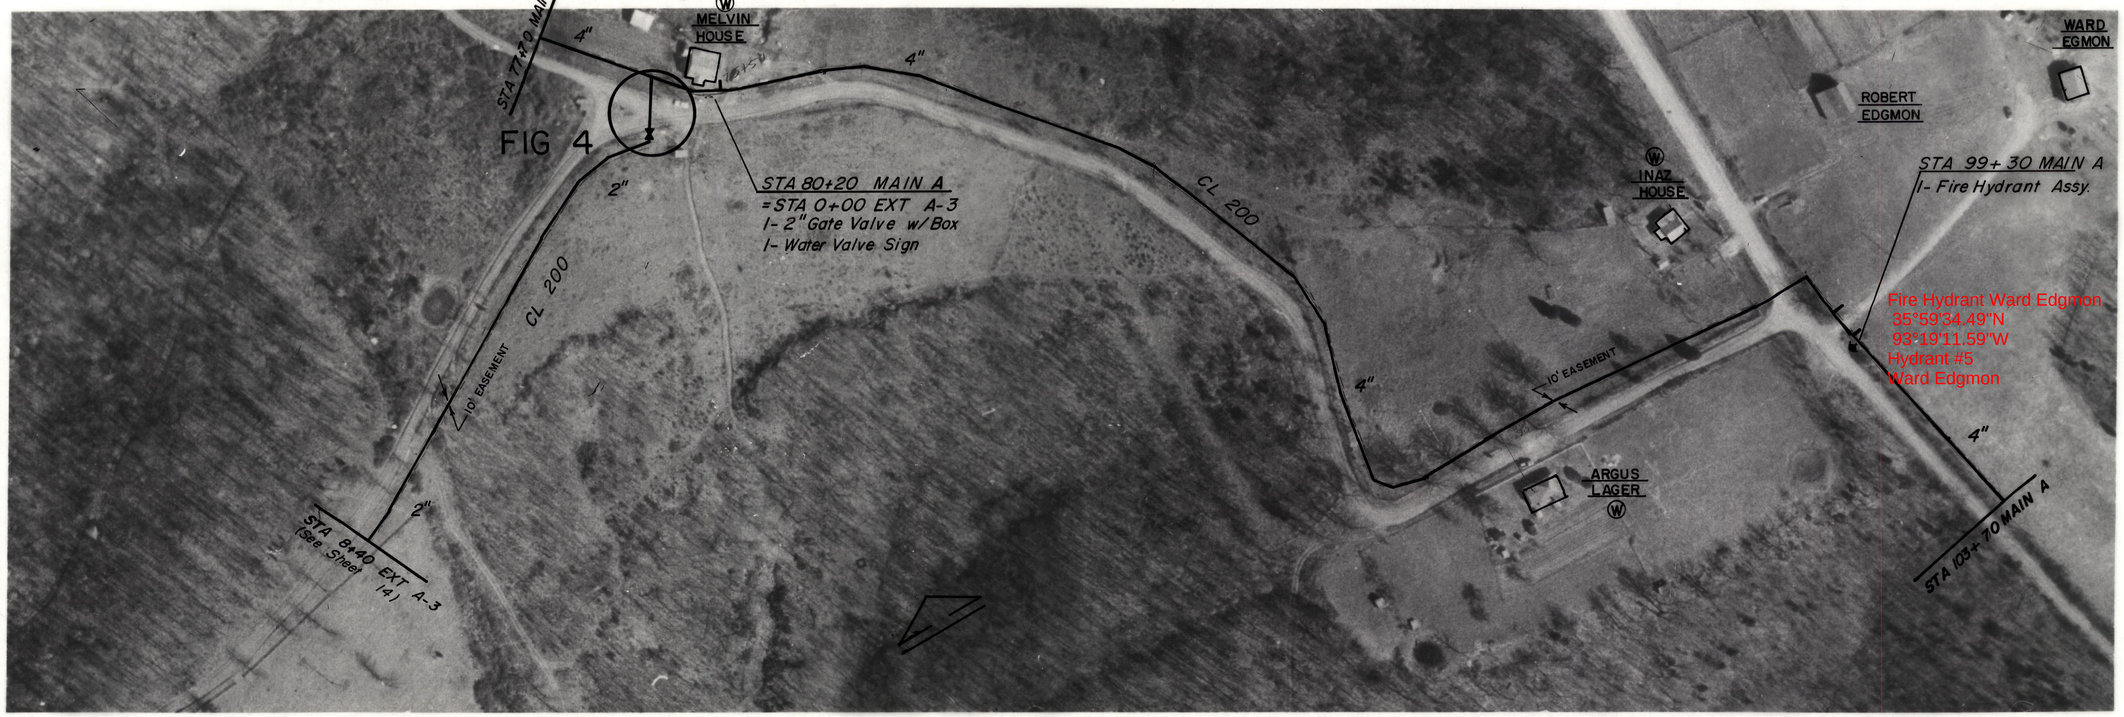

EXT A-3

NOTE:

THE CONTRACTOR SHALL BE RESPONSIBLE FOR DETERMINING EXACT LOCATIONS OF EXISTING UTILITIES.

MAIN A

EXT A-4

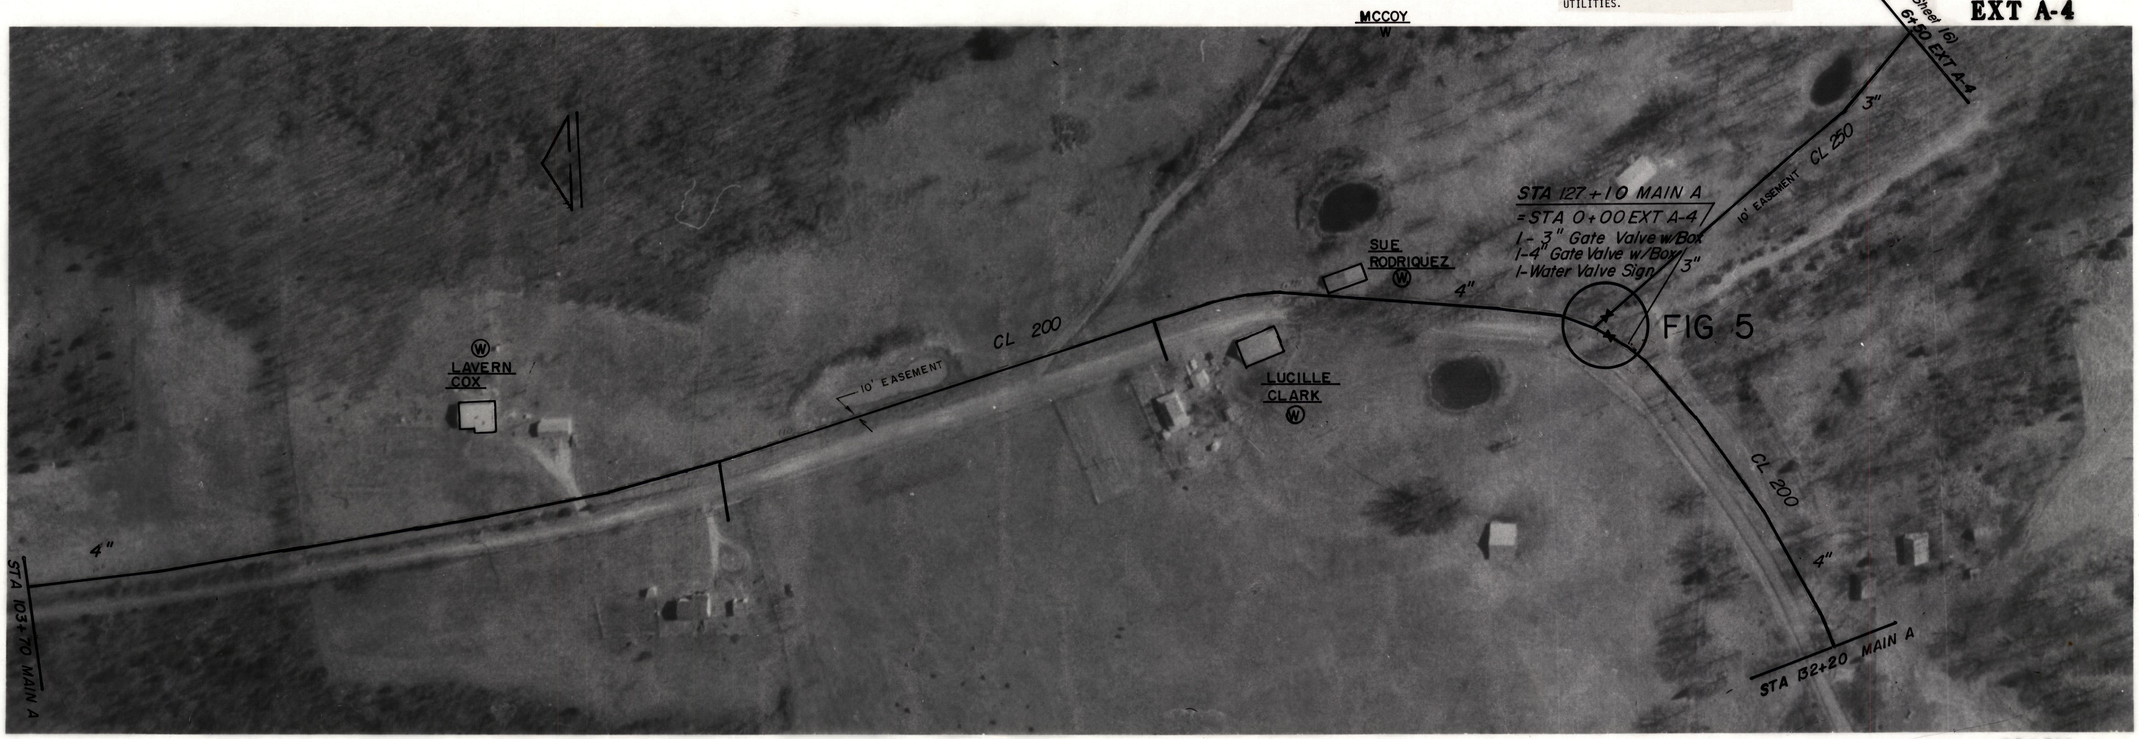

MAIN A

RECORD DRAWING
OCT 1988

DATE	REVISIONS

SURVEY BY: AHTD
DESIGN BY: CJM
DRAWN BY: RAH
CHECKED BY: RWT

WATER SYSTEM IMPROVEMENT FOR

MT. SHERMAN WATER ASSOCIATION

NEWTON COUNTY ARKANSAS

MAIN A, EXT A-3 & EXT A-4

Blaylock Threet Phillips and Associates Inc.
consulting engineers
MECHANICAL - ELECTRICAL
CIVIL - SURVEYING
1501 MARKET DR
LITTLE ROCK, ARKANSAS 72211
(501) 224-3922

STATE OF ARKANSAS
REGISTERED PROFESSIONAL ENGINEER
RAWLAND E. BLAYLOCK 814
ROBERT W. THREET 2159
JAMES E. PHILLIPS 3628

SCALE
1" = 100' - 0"

DATE	PROJECT NO.
JULY 1987	87 040 2

SHEET 5 OF 19