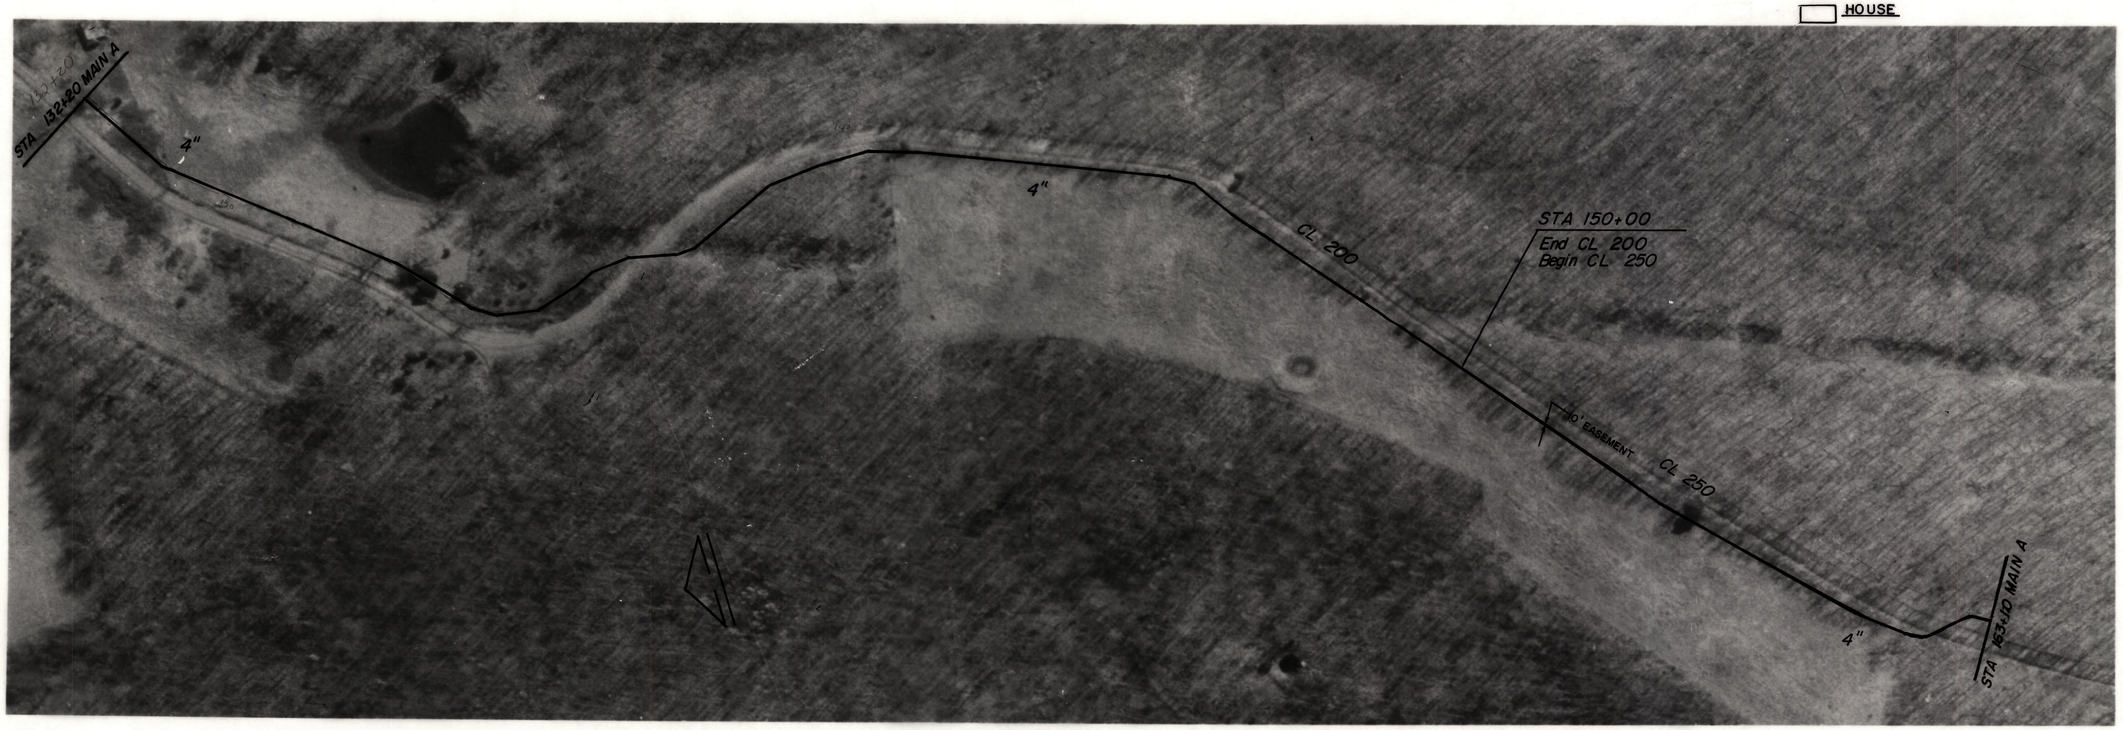

NOTE:

THE CONTRACTOR SHALL BE RESPONSIBLE FOR DETERMINING EXACT LOCATIONS OF EXISTING UTILITIES.

MAIN A

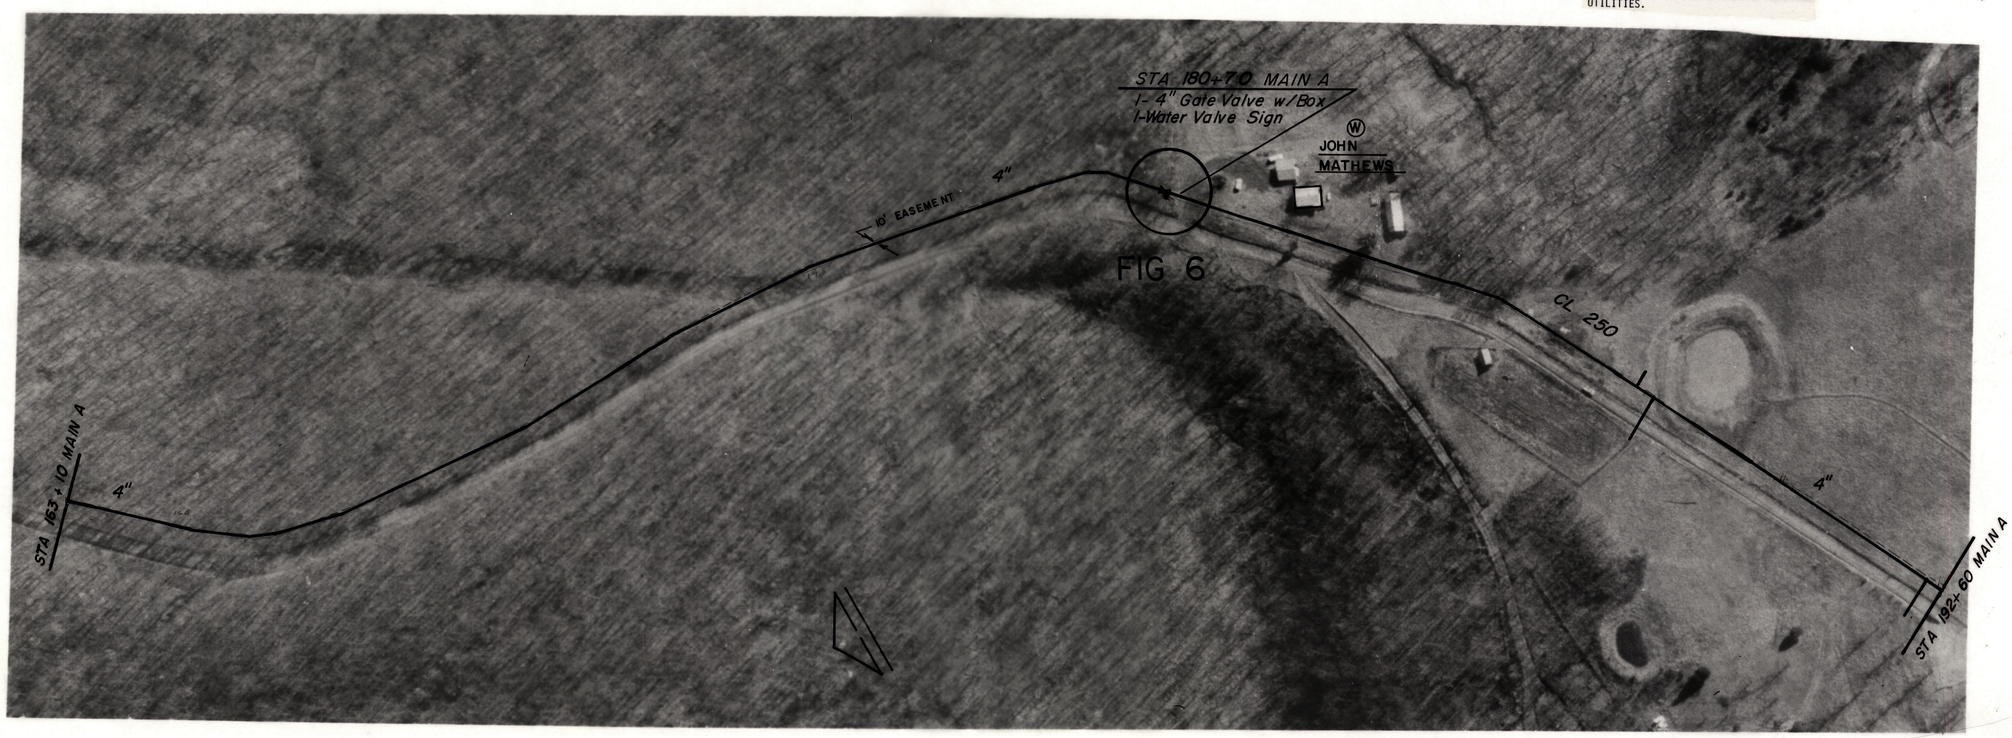

MAIN A

MICHAEL HALPIN W

BIBLE COLLEGE W

RECORD DRAWING
OCT 1988

DATE	REVISIONS

SURVEY BY: AHTD
DESIGN BY: CJM
DRAWN BY: RAH
CHECKED BY: RWT

WATER SYSTEM IMPROVEMENT FOR

MT. SHERMAN WATER ASSOCIATION

NEWTON COUNTY ARKANSAS

MAIN A

Blaylock Threet Phillips and Associates Inc.
consulting engineers
MECHANICAL - ELECTRICAL
CIVIL - SURVEYING
1501 MARKET DR.
LITTLE ROCK, ARKANSAS 72211
(501) 224-3922

STATE OF ARKANSAS
REGISTERED PROFESSIONAL ENGINEER
RAWLAND E. BLAYLOCK 614
ROBERT M. THREET 1189
JAMES R. PHILLIPS 3026

SCALE
1" = 100'- 0"

DATE	PROJECT NO.
JULY 1987	87 040 2

SHEET 6 OF 19