NOTE:

THE CONTRACTOR SHALL BE RESPONSIBLE FOR DETERMINING EXACT LOCATIONS OF EXISTING UTILITIES.

MAIN A

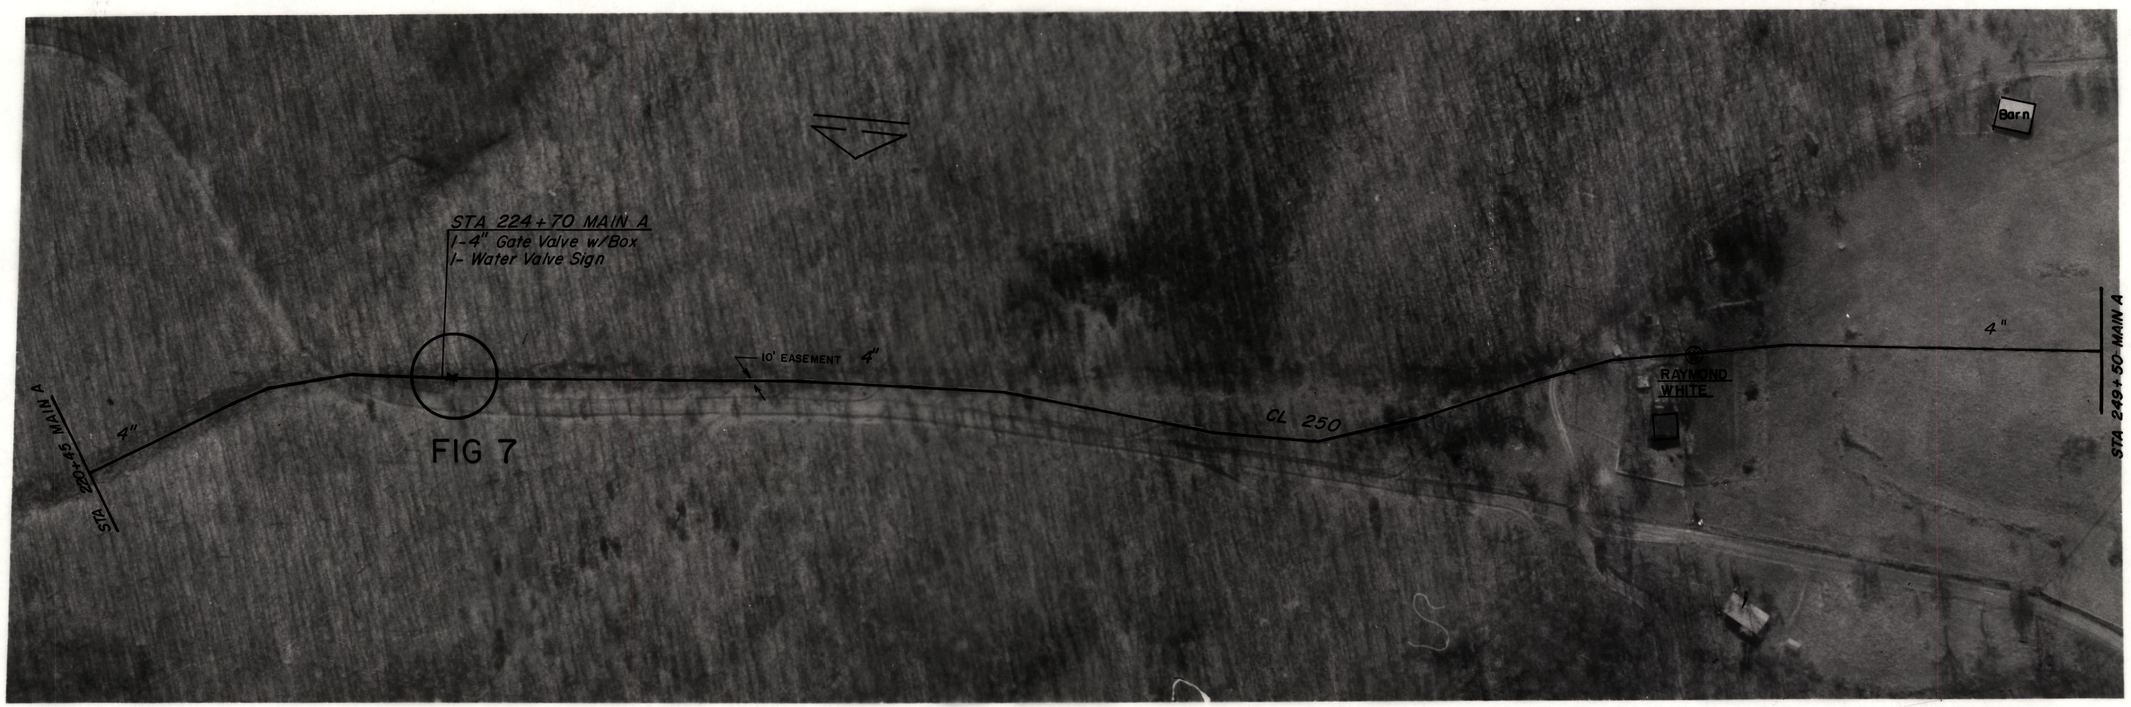


MAIN A

RECORD DRAWING
OCT 1988

| DATE | REVISIONS |
|---|---|
| | |

SURVEY BY: AHTD
DESIGN BY: CJM
DRAWN BY: RAH
CHECKED BY: RWT

WATER SYSTEM IMPROVEMENT FOR

# MT. SHERMAN WATER ASSOCIATION

NEWTON COUNTY ARKANSAS

MAIN A

Blaylock Threet Phillips and Associates Inc.
consulting engineers
MECHANICAL - ELECTRICAL
CIVIL - SURVEYING
1501 MARKET DR.
LITTLE ROCK, ARKANSAS 72211
(501) 224-3922

STATE OF ARKANSAS
REGISTERED PROFESSIONAL ENGINEER
RANDAL E. BLAYLOCK 814
ROBERT N. THREET 1186
JAMES D. PHILLIPS 3828

SCALE 1" = 100'-0"

| DATE | PROJECT NO. |
|---|---|
| JULY 1987 | 87 040 2 |

SHEET 7 OF 19